

STATE ENGINEER
Salem, Oregon

Well Record
MARION COUNTY

STATE WELL NO. 7/2W-11D(1)
COUNTY Marion
APPLICATION NO. GR-16

OWNER: H. P. Hansen


MAILING ADDRESS: Route 6, Box 397

LOCATION OF WELL: Owner's No.

CITY AND STATE: Salem, Oregon

NW 1/4 NW 1/4 Sec. 11 T. 7 S., R. 2 W., W.M.

Bearing and distance from section or subdivision corner 1122 feet West and 280 feet South from SW corner, N1/2 of William Greenwood DLC

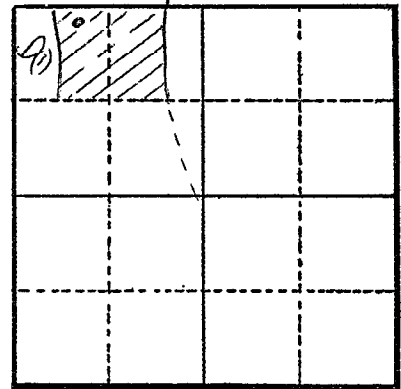

Section 11

Altitude at well 250 feet interpolated

TYPE OF WELL: Drilled Date Constructed May 1, 1952

Depth drilled 135 feet Depth cased 135 feet

CASING RECORD:

8-inch casing set from 0 to 135 feet

FINISH:

perforations placed from 115 to 135 feet

AQUIFERS:

WATER LEVEL:

40 feet below land surface

PUMPING EQUIPMENT: Type Berkeley Turbine H.P. 15
Capacity 200 G.P.M.

WELL TESTS:

Drawdown ft. after hours 200 G.P.M.
Drawdown ft. after hours G.P.M.

USE OF WATER Irrigation 60 Temp. °F., 19

SOURCE OF INFORMATION GR-13
DRILLER or DIGGER Staedeli, Silverton, Oregon

ADDITIONAL DATA:

Log no Water Level Measurements Chemical Analysis Aquifer Test

REMARKS: