

STATE ENGINEER
Salem, Oregon

MARI 700

Well Record

STATE WELL NO. 4/1W-22D(2)
COUNTY Marion
APPLICATION NO. GR-1164

GR- 1125

OWNER: Nick Zauner

MAILING ADDRESS:


LOCATION OF WELL: Owner's No.

CITY AND STATE: Aurora, Oregon

NW 1/4 NW 1/4 Sec. 22 T. 4 S., R. 1 W., W.M.

Bearing and distance from section or subdivision

corner 740' S. 470' E. from NW cor. Sec. 22.

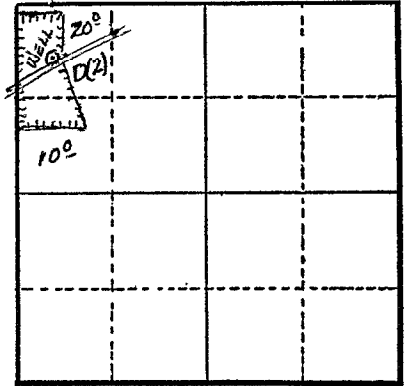

Section 22

Altitude at well 177 ft.

TYPE OF WELL: Drilled Date Constructed 1951

Depth drilled 117 ft. Depth cased 117 ft.

CASING RECORD:

8 inch

FINISH:

Mill knife perforations - 36 holes (Zig-Zag) from 110 to 115 ft.

AQUIFERS:

WATER LEVEL:

32 ft.

PUMPING EQUIPMENT: Type Turbine H.P. 15
Capacity 200 G.P.M.

WELL TESTS:

Drawdown 68 ft. after 200 hours G.P.M.

Drawdown ft. after hours G.P.M.

USE OF WATER Irrigation 30 acres Temp. °F. 19.

SOURCE OF INFORMATION G. R. Record

DRILLER or DIGGER

ADDITIONAL DATA:

Log Water Level Measurements Chemical Analysis Aquifer Test

REMARKS:

Log: Surface 0 to 4 ft.
Yellow clay 4 to 26 ft.
Surface sand 26 to 29 ft.
Broken sand & clay 29 to 73 ft.
Blue clay 73 to 84 ft.
Black sand (water) 84 to 96 ft.
Broken sand & gravel 96 to 118 ft.

Irrigation of 30 acres.