

STATE OF OREGON
 WATER SUPPLY WELL REPORT
 (as required by ORS 537.765 & OAR 690-205-0210)

WELL I.D. LABEL# L 141207
 START CARD # 1053511
 ORIGINAL LOG #

(1) LAND OWNER Owner Well I.D. 6278
 First Name Jeremy & Casey Last Name Lundberg
 Company _____
 Address 12831 Jefferson Hwy. 99E SE
 City Jefferson State OR Zip 97352

(2) TYPE OF WORK New Well Deepening Conversion
 Alteration (complete 2a & 10) Abandonment (complete 5a)

(2a) PRE-ALTERATION
 Dia + From To Gauge Stl Plstc Wld Thrd
 Casing: _____
 Material From To Amt sacks/lbs
 Seal: _____

(3) DRILL METHOD
 Rotary Air Rotary Mud Cable Auger Cable Mud
 Reverse Rotary Other _____

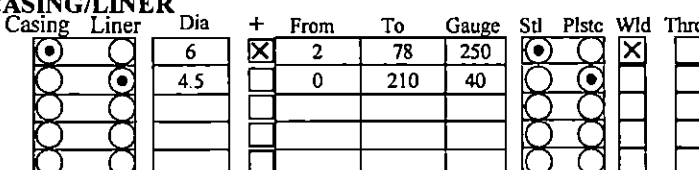
(4) PROPOSED USE Domestic Irrigation Community
 Industrial/ Commercial Livestock Dewatering
 Thermal Injection Other _____

(5) BORE HOLE CONSTRUCTION Special Standard (Attach copy)
 Depth of Completed Well 210 ft.

| BORE HOLE | | | SEAL | | | sacks/ lbs | |
|-----------|------|-----|-----------|------|----|------------|----|
| Dia | From | To | Material | From | To | Amt | S |
| 10 | 0 | 78 | Bentonite | 0 | 78 | 39 | S |
| 6 | 78 | 210 | | | | Calculated | 37 |
| | | | | | | Calculated | |

How was seal placed: Method A B C D E
 Other Poured dry
 Backfill placed from _____ ft. to _____ ft. Material _____
 Filter pack from _____ ft. to _____ ft. Material _____ Size _____
 Explosives used: Yes Type _____ Amount _____

(5a) ABANDONMENT USING UNHYDRATED BENTONITE
 Proposed Amount Pounds Actual Amount Pounds

(6) CASING/LINER
 Casing Liner Dia + From To Gauge Stl Plstc Wld Thrd

 Shoe Inside Outside Other Location of shoe(s) _____
 Temp casing Yes Dia _____ From _____ To _____

(7) PERFORATIONS/SCREENS
 Perforations Method Drilled 1/4" holes
 Screens Type _____ Material _____

| Perf/Screen | Casing/Screen Liner | Dia | From | To | Scr/slot width | Slot length | # of slots | Tel/pipe size |
|-------------|---------------------|-----|------|-----|----------------|-------------|------------|---------------|
| Perf | Liner | 4.5 | 130 | 210 | .25 | .25 | 1,000 | |

(8) WELL TESTS: Minimum testing time is 1 hour
 Pump Bailer Air Flowing Artesian

| Yield gal/min | Drawdown | Drill stem/Pump depth | Duration (hr) |
|---------------|----------|-----------------------|---------------|
| 60 | | 208 | 1 |

Temperature 53 °F Lab analysis Yes By _____
 Water quality concerns? Yes (describe below) TDS amount 154

| From | To | Description | Amount | Units |
|------|----|-------------|--------|-------|
| | | | | |

(9) LOCATION OF WELL (legal description)
 County MARION Twp 10 S N/S Range 2 W E/W WM
 Sec 7 SE 1/4 of the SW 1/4 Tax Lot 200
 Tax Map Number _____ Lot _____
 Lat _____ or _____ DMS or DD
 Long _____ or _____ DMS or DD
 Street address of well Nearest address

behind 16477 Emerald Green Ln. SE - Jefferson, OR 97352

(10) STATIC WATER LEVEL

| Existing Well / Pre-Alteration | Date | SWL(psi) | + SWL(ft) |
|--------------------------------|------------|----------|-----------|
| Completed Well | 09-17-2021 | | 100 |

 Flowing Artesian? Dry Hole?

WATER BEARING ZONES Depth water was first found 40

| SWL Date | From | To | Est Flow | SWL(psi) | + SWL(ft) |
|------------|------|-----|----------|----------|-----------|
| 09-17-2021 | 40 | 65 | 5 | | 30 |
| 09-17-2021 | 165 | 170 | 60 | | 100 |

(11) WELL LOG Ground Elevation _____

| Material | From | To |
|---------------------------------------|------|-----|
| Topsoil | 0 | 1 |
| Brown decomposed rock | 1 | 19 |
| Gray clay w/some gravel | 19 | 25 |
| Decomposed sandstone | 25 | 30 |
| Tan broken sandstone | 30 | 35 |
| Brown weathered sandstone | 35 | 40 |
| Tan sandstone w/strips of iron fouled | 40 | 50 |
| Conglomerate sandstone | 50 | 55 |
| Decomposed sandstone | 55 | 65 |
| Green sandstone | 65 | 70 |
| Hatrd gray sandstone | 70 | 210 |

JONES DRILLING CO., INC. RECEIVED
 29400 SANTIAM HWY.
 LEBANON, OR 97355
 541-367-2560 541-451-2686
 1-800-915-8388
 SEP 27 2021
 OWRD

Date Started 09-17-2021 Completed 09-17-2021

(unbonded) Water Well Constructor Certification
 I certify that the work I performed on the construction, deepening, alteration, or abandonment of this well is in compliance with Oregon water supply well construction standards. Materials used and information reported above are true to the best of my knowledge and belief.
 License Number 1888 Date 09-21-2021
 Signed *Alan Hullett*

(bonded) Water Well Constructor Certification
 I accept responsibility for the construction, deepening, alteration, or abandonment work performed on this well during the construction dates reported above. All work performed during this time is in compliance with Oregon water supply well construction standards. This report is true to the best of my knowledge and belief.
 License Number 1684 Date 09-21-2021
 Signed _____
 Contact Info (optional) jonesdrilling@hotmail.com