

STATE ENGINEER  
Salem, Oregon

MAR 70 17

# Well Record

STATE WELL NO. 7/2W-12 E  
COUNTY Marion  
APPLICATION NO. GR-913

OWNER: Elton L. Watts


MAILING ADDRESS: Route 2, Box 271

LOCATION OF WELL: Owner's No. # 1

CITY AND STATE: Silverton

SW 1/4 NW 1/4 Sec. 12 T. 7 S., R. 2 W., W.M.

Bearing and distance from section or subdivision  
corner 1950 feet South and 1300 feet East from the  
NW Corner, Section 12

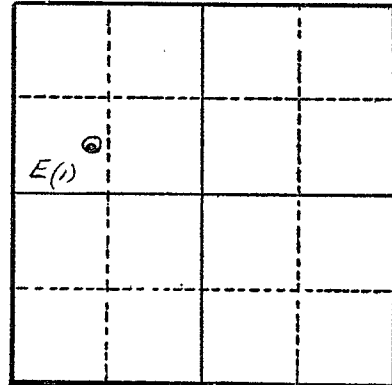

Section 12

Altitude at well \_\_\_\_\_

TYPE OF WELL: Drilled Date Constructed Apr. 1952

Depth drilled 125 feet Depth cased 125 feet

### CASING RECORD:

10-inch steel 0 to 125 feet

### FINISH:

perforated 410 perforations 72 to 125 feet

### AQUIFERS:

gravel 123 to 125 feet

### WATER LEVEL:

15 feet

PUMPING EQUIPMENT: Type Berkley Turbine H.P. 20 Elec.  
Capacity 480 G.P.M. U.S. Motor

### WELL TESTS:

Drawdown 37 ft. after \_\_\_\_\_ hours 480 G.P.M.

Drawdown 21 ft. after \_\_\_\_\_ hours 375 G.P.M.

USE OF WATER Irrigation Temp. \_\_\_\_\_ °F., 19 \_\_\_\_\_

SOURCE OF INFORMATION GR-887

DRILLER or DIGGER J. A. Sneed & Sons 2505 Brooks Street, Salem

### ADDITIONAL DATA:

Log x Water Level Measurements \_\_\_\_\_ Chemical Analysis \_\_\_\_\_ Aquifer Test \_\_\_\_\_

### REMARKS:

Soil 0 72  
Gravel, cemented 72 123  
Gravel, (water) 123 125