
NOTICE TO WATER WILL CONTRACTOR
The original and first copy

WATER WELL REPORT

The original and first copy of this report are to be filed with the

STATE ENGINEER, SALEM, OREGON 97310 AN 25 197 to investigation of well completion.

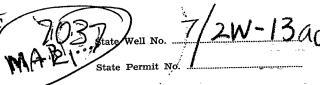

(1) OWNER:	(10) LOCATION OF WELL:		
	County Marion Driller's well num		· Type of the control
Address Rte.2.Box	S.E. 14 N.E 14 Section 13 T.7 S. F		W.M.
Silverton Oregon 97381	Bearing and distance from section or subdivision	ı corner	
(2) TYPE OF WORK (check):	Approx.1700 ft.south & 20	ft.west c	of N.E
New Well → Deepening □ Reconditioning □ Abandon □	corner of Sec.13, T.7 S., R	2 W.of V	V.M.
If abandonment, describe material and procedure in Item 12.	(11) WATER LEVEL: Completed we	11.	
	Depth at which water was first found	xx	ft.
	1.0	urface Date 7 /	
Rotary Driven Domestic Industrial Municipal Cable A Jetted D			<u> </u>
Dug	Artesian pressure XX lbs. per square	inch. Date	
CASING INSTALLED: Threaded Welded	(12) WELL LOG: Diameter of well be	olow ansing	9
10 to 40 ft Gage 250	Depth drilled $210\frac{1}{2}$ ft. Depth of completed well 210 ft.		
10 " Diam. from 0 ft. to 40 ft. Gage • 250 10 " Diam. from 40 ft. to 165 ft. Gage • 279	Formation: Describe color, texture, grain size and structure of materials;		
"Diam. from ft. to ft. Gage	and at any thickness and nature of each stratum	n and adulier be	menaieu,
Diam. Hom	with at least one entry for each change of formati position of Static Water Level and indicate princ	ion. Report each	cnange in
PERFORATIONS: Perforated? A Yes No.	position of Static Water Level and marcate princ		
Type of perforator used Mills Knife	MATERIAL	From To	SWL
Size of perforations 3/8 in, by 3 in.	Top soil-brn.	0 8	
48 109 ft to 104 ft.	Clay-brn.	2 15	
368 1 nerforations from 91 ft. to 57 102 ft.	Clay-grey & sticky	15 30	
189	Sandy clay-brn. & soft	30 34	
	Sandy clay-brn. with -	711 117	
(7) SCREENS: Well screen installed? Yes No	scattered med.gravel,firm	34 47	
Wantulacource & Liame to the second s	Med.congl. hdbrn.(W.B.)	47 <u>58</u> 51	
Model No.	Packed sand-brn. & soft	20 01	
Diam. Slot size Set from ft. to ft.	sandy clay-br., soit with	61 67	
Diam, Slot size Set from ft. to ft.	scattered med. gravel- MED.congl.br.hard-(W.B.)	67 91	
(8) WELL TESTS: Drawdown is amount water level is lowered below static level	Clay-grey - soft-	91 104	<u> </u>
<u> </u>	Med.conglgrey,hd(W.B.)	104 110	
	Course-sand-grey-with-		7
Yield: 212 gal./min. with 7 tt. drawdown after Onts.	some clay-	110 113	
100 " 58 " 8 "	Clay-grey-soft & sticky	113 135	
" " "	Fine-sandy-clay-greyish-b	1.135 147	
Bailer test XX gal./min. with ft. drawdown after hrs.	Clay-grey-soft & sticky	147 165	
The state of the s	Racaltegrev-very hard-	165 172	
Artesian flow g.p.m. Zemperature of water XX Depth artesian flow encountered XX ft.	Basalt-black-very hard- Work started June 16 1854 Complet	ed July 15	2 1964
paraperature of water XX Depth artesian now encountered	Date well drilling machine moved off of well	July 15	1964
(9) CONSTRUCTION:			
Well seal—Material used Bentonite & puddled clay	Drilling Machine Operator's Certification	: / direct supe	rvision
Well sealed from land surface toft.	This well was constructed under my direct supervision Materials used and information reported above are true to my		
Diameter of well bore to bottom of sealin.	best knowledge and belief the best knowledge and best knowledge and belief the best knowledge and best knowle		
Diameter of well bore below sealin.	[Signed] James A. State (Drilling Machine Operator)	Date	, 192/
Number of sacks of cement used in well sealsacks	Drilling Machine Operator's License No.	16	
Number of sacks of bentonite used in well seal approx • 1 sacks			
Brand name of bentonite	Water Well Contractor's Certification:		
Number of pounds of bentonite per 100 gallons	This well was drilled under my jurisdiction and this report is true to the best of my knowledge and belief.		
of water	Name R. Stadeli & Sons		
Did any strata contain unusable water? Yes K No	(Person, firm or corporation)	(Type or)	
	Address Rte. 3, Box 169, Silve	rton,Ore	zon
	Quelle State	I'm	
Method of sealing strata off	[Signed] (Water Well Con		************
Was well gravel packed? ☐ Yes 🔀 No Size of gravel:	Contractor's License No. 296 Date	Aug•3	, 1954
Gravel placed from ft. to ft.	1		CD#45656_1