

STATE ENGINEER
Salem, Oregon

7053
MARI

Well Record

STATE WELL NO. 7/2W-13N(1)
COUNTY Marion
APPLICATION NO. GR-1221

GR- 1181

OWNER: Carl D. Vogt


MAILING ADDRESS: Rt. 2, Box 603

LOCATION OF WELL: Owner's No.

CITY AND STATE: Salem, Oregon

SW 1/4 SW 1/4 Sec. 13 T. 7 S., R. 2 W., W.M.

Bearing and distance from section or subdivision corner 957' N. & 495' E. from SW cor. Sec. 13.

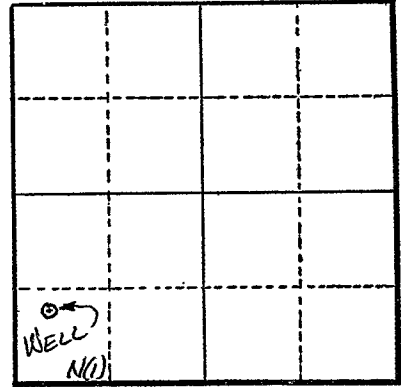

Section 13

Altitude at well 224 ft.

TYPE OF WELL: Drilled Date Constructed 1909

Depth drilled 350 ft. Depth cased 350 ft.

CASING RECORD:

- 12 in. steel from 0 to 150 ft.
- 8 in. steel from 150 to 350 ft.

FINISH:

AQUIFERS:

WATER LEVEL:

50 ft.

PUMPING EQUIPMENT: Type Pamona turbine H.P. 5
Capacity 80 G.P.M.

WELL TESTS:

Drawdown 55 ft. after 80 hours G.P.M.

Drawdown ft. after hours G.P.M.

USE OF WATER Irrigation Temp. °F. 19

SOURCE OF INFORMATION G. R. Record

DRILLER or DIGGER

ADDITIONAL DATA:

Log N.A. Water Level Measurements Chemical Analysis Aquifer Test

REMARKS:

Irrigation of 6.5 acres.