

STATE OF OREGON
WATER SUPPLY WELL REPORT
(as required by ORS 537.765 & OAR 690-205-0210)

WELL I.D. LABEL# L
START CARD # 1059070
ORIGINAL LOG #

(1) LAND OWNER
Owner Well I.D. 6418
First Name
Last Name
Company
City of Jefferson
Address P.O. Box 83
City Jefferson State OR Zip 97352

(2) TYPE OF WORK
New Well
Deepening
Conversion
Alteration (complete 2a & 10)
Abandonment (complete 5a)

(2a) PRE-ALTERATION
Dia + From To Gauge Stl Plstc Wld Thrd
Casing:
Material From To Amt sacks/lbs
Seal:

(3) DRILL METHOD
Rotary Air
Rotary Mud
Cable
Auger
Cable Mud
Reverse Rotary
Other

(4) PROPOSED USE
Domestic
Irrigation
Community
Industrial/ Commercial
Livestock
Dewatering
Thermal
Injection
Other City well

(5) BORE HOLE CONSTRUCTION
Special Standard
Depth of Completed Well 0 ft.

Table with columns: Dia, From, To, Material, SEAL, Amt, lbs. Rows include Cement and Bentonite.

How was seal placed: Method A B C D E
Other Poured dry
Backfill placed from ft. to ft. Material
Filter pack from ft. to ft. Material Size
Explosives used: Yes Type Amount

(5a) ABANDONMENT USING UNHYDRATED BENTONITE
Proposed Amount Pounds
Actual Amount Pounds

(6) CASING/LINER
Casing Liner Dia + From To Gauge Stl Plstc Wld Thrd
Shoe Inside Outside Other Location of shoe(s)
Temp casing Yes Dia From To

(7) PERFORATIONS/SCREENS
Perforations Method Holte air perforator
Screens Type Material
Perf/S Casing/Screen Dia From To Scrm/slot Slot # of Tele/
green Liner Dia From To width length slots pipe size

(8) WELL TESTS: Minimum testing time is 1 hour
Pump
Bailer
Air
Flowing Artesian
Yield gal/min Drawdown Drill stem/Pump depth Duration (hr)
Temperature °F Lab analysis Yes By
Water quality concerns? Yes (describe below) TDS amount
From To Description Amount Units

(9) LOCATION OF WELL (legal description)
County MARION Twp 10 S N/S Range 3 W E/W WM
Sec 12 NE 1/4 of the SW 1/4 Tax Lot 400
Tax Map Number Lot
Lat " or 44.71512857 DMS or DD
Long " or -123.00246019 DMS or DD
Street address of well Nearest address
284 S. 7th St. - Jefferson, OR 97352

(10) STATIC WATER LEVEL
Date SWL(psi) + SWL(ft)
Existing Well / Pre-Alteration
Completed Well
Flowing Artesian? Dry Hole?

WATER BEARING ZONES
Depth water was first found
SWL Date From To Est Flow SWL(psi) + SWL(ft)

(11) WELL LOG
Ground Elevation
Material From To
Cleaned out to bottom of well 560'
Perforated existing casing 4' - 300' 4 rows of perforations
Removed 5' of existing 8" casing from +1' - 4'
RECEIVED
NOV 17 2022
JONES DRILLING CO., INC.
29400 SANTIAM HWY.
LEBANON, OR 97355
541-367-2560 541-451-2686
1-800-915-8388
OWRD

Date Started 11-04-2022 Completed 11-08-2022

(unbonded) Water Well Constructor Certification
I certify that the work I performed on the construction, deepening, alteration, or abandonment of this well is in compliance with Oregon water supply well construction standards. Materials used and information reported above are true to the best of my knowledge and belief.
License Number 2050 Date 11-14-2022
Signed

(bonded) Water Well Constructor Certification
I accept responsibility for the construction, deepening, alteration, or abandonment work performed on this well during the construction dates reported above. All work performed during this time is in compliance with Oregon water supply well construction standards. This report is true to the best of my knowledge and belief.
License Number 1684 Date 11-14-2022
Signed
Contact Info (optional) jonesdrilling@hotmail.com

MARI 70653

Oregon Water Resources Department
Groundwater Use Recording Mapping Tool

725 Summer St NE, Sale

Step 1: Search for Well

Step 2: Create Well Map

Mark Well Point and Create Map:

Zoom in closer to the well location, if needed.
Mark the location of the well by either of these two methods:

A. Drawing on the map using the draw tool

Click on Icon and draw a point on the map

B. Type in the GPS Decimal Degrees:

GPS Latitude: 44.71512857
GPS Longitude: -123.00246019

Mark Point Clear Point

[Converter](#)

Results:

Latitude: 44.71512857
Longitude: -123.00246019

Complete the form:


Submitted by:

Address of Well:

City:

Special Notes:

◀ ▶

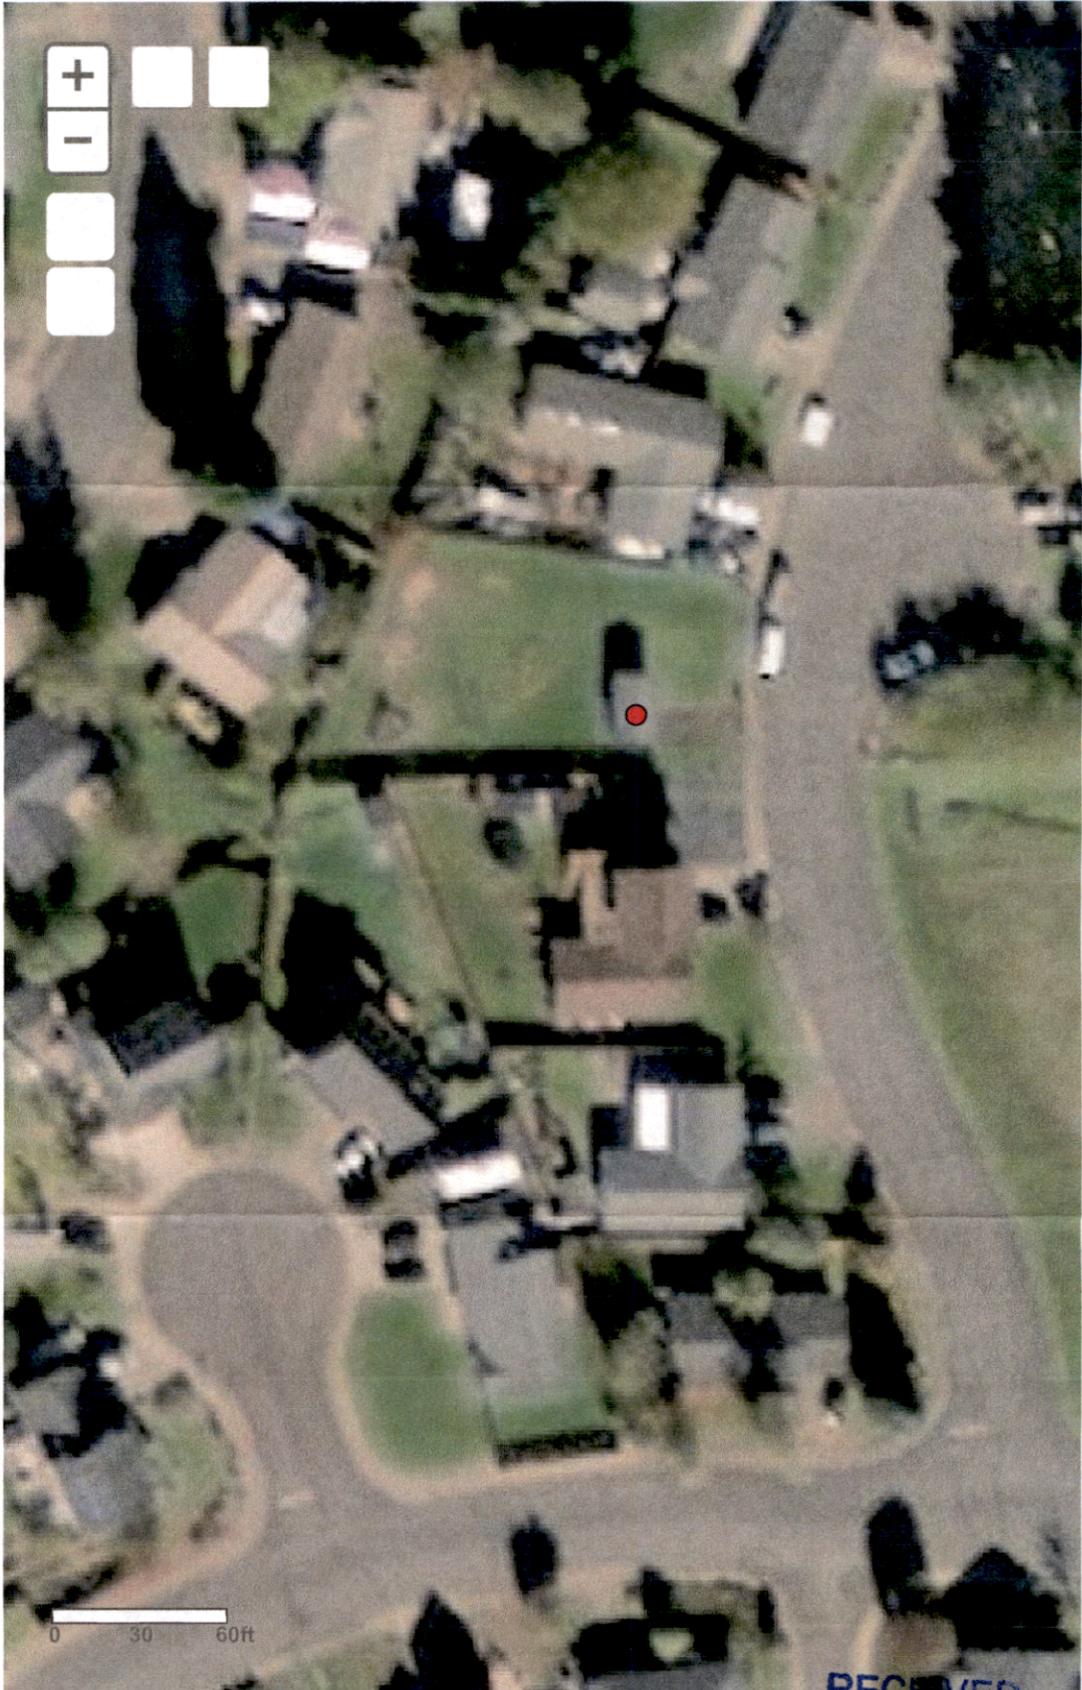

Handwritten marks: ~~ES~~ 1N

RECEIVED
NOV 17 2022
OWRD