

STATE ENGINEER
Salem, Oregon


7078
MAR 21 1953

Well Record

STATE WELL NO. 7/2W-14C(1)
COUNTY Marion
APPLICATION NO. GR-137

OWNER: John Lauderback
MAILING ADDRESS: _____
CITY AND STATE: Salem, Oregon

LOCATION OF WELL: Owner's No. 1
NE 1/4 NW 1/4 Sec. 14 T. 7 S., R. 2 W., W.M.

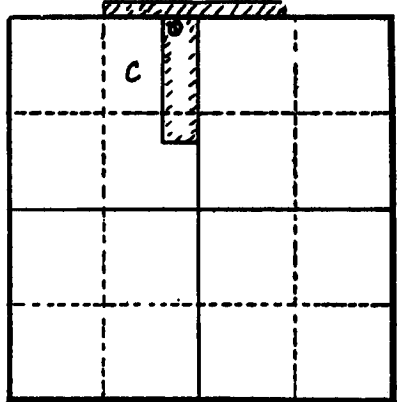

Bearing and distance from section or subdivision corner
7 chains west and 1 chain south from the NW corner, Section 14

Altitude at well 200 feet interpolated

TYPE OF WELL: Drilled Date Constructed Dec. 1953

Depth drilled 135 Depth cased 135

Section 14

CASING RECORD:

8-inch steel casing set from 0 to 135 feet

FINISH:

4 perforations every 18" 1/4"x3" long from 50 to 134 feet

AQUIFERS:

gravel from 80 to 135 feet

WATER LEVEL:

35 feet below land surface 1-13-54

PUMPING EQUIPMENT: Type Fairbanks-Morse H.P. 15
Capacity 220 G.P.M.

WELL TESTS:

Drawdown 33 ft. after 300 hours G.P.M.
Drawdown 39 ft. after 450 hours G.P.M.

USE OF WATER Irrigation 27.06 Temp. °F. 19

SOURCE OF INFORMATION GR-127

DRILLER or DIGGER Rudolph Stadlie

ADDITIONAL DATA:

Log Water Level Measurements _____ Chemical Analysis _____ Aquifer Test _____

REMARKS:

Top soil	0	4	4	Gravel, cement (water)	81	106	25
Loam	4	25	21	Sand & gravel (pea)	106	111	5
Clay	25	50	25	Gravel, cement	111	134	23
Gravel, cement (water)	50	80	30	Gravel, loose	134	135	1
Gravel, loose (water)	80	81	1				