

STATE OF OREGON
WATER SUPPLY WELL REPORT
(as required by ORS 537.765 & OAR 690-205-0210)

WELL I.D. LABEL# 1 143506
START CARD # 1059570
ORIGINAL LOG #

(1) LAND OWNER
Owner Well I.D. 6429
First Name
Company City of Monmouth
Address 401 Hogan Rd.
City Monmouth State OR Zip 97361

(2) TYPE OF WORK
[X] New Well [ ] Deepening [ ] Conversion
[ ] Alteration (complete 2a & 10) [ ] Abandonment (complete 5a)

(2a) PRE-ALTERATION
Dia + From To Gauge Stl Plstc Wld Thrd
Casing:
Material From To Amt sacks/lbs
Seal:

(3) DRILL METHOD
[X] Rotary Air [ ] Rotary Mud [ ] Cable [ ] Auger [ ] Cable Mud
[ ] Reverse Rotary [ ] Other

(4) PROPOSED USE
[ ] Domestic [ ] Irrigation [X] Community
[ ] Industrial/ Commercial [ ] Livestock [ ] Dewatering
[ ] Thermal [ ] Injection [ ] Other

(5) BORE HOLE CONSTRUCTION
Special Standard [X] (Attach copy)
Depth of Completed Well 56 ft.

Table with columns: Dia, From, To, Material, SEAL, Amt, Sacks/lbs. Rows include Cement and Bentonite.

How was seal placed: Method [ ] A [ ] B [X] C [ ] D [ ] E
[X] Other poured dry
Backfill placed from ft. to ft. Material
Filter pack from 32 ft. to 56 ft. Material round rock Size 3/8"

(5a) ABANDONMENT USING UNHYDRATED BENTONITE
Proposed Amount Pounds Actual Amount Pounds

(6) CASING/LINER
Casing Liner Dia + From To Gauge Stl Plstc Wld Thrd
Shoe [ ] Inside [ ] Outside [ ] Other Location of shoe(s)
Temp casing [X] Yes Dia 16 From 0 To 56

(7) PERFORATIONS/SCREENS
Perforations Method
Screens Type Wrap rib Material Stainless steel
Perf/S Casing/Screen Dia From To Scrn/slot Slot # of Tel/
reen Liner Dia From To width length slots pipe size

(8) WELL TESTS: Minimum testing time is 1 hour
Pump [X] Bailer [ ] Air [ ] Flowing Artesian [ ]
Yield gal/min Drawdown Drill stem/Pump depth Duration (hr)
1,284 2 42 9.8

Temperature 62 °F Lab analysis [ ] Yes By
Water quality concerns? [ ] Yes (describe below) TDS amount 76 ppm
From To Description Amount Units

(9) LOCATION OF WELL (legal description)
County MARION Twp 8 S N/S Range 4 W E/W WM
Sec 28 NE 1/4 of the SE 1/4 Tax Lot No tax lot
Tax Map Number Lot
Lat " or 44.846 DMS or DD
Long " or -123.176 DMS or DD
[ ] Street address of well [X] Nearest address

Marion County road right of way

(10) STATIC WATER LEVEL
Date SWL(psi) + SWL(ft)
Existing Well / Pre-Alteration
Completed Well 03-14-2023 21.6
Flowing Artesian? [ ] Dry Hole? [ ]

WATER BEARING ZONES
Depth water was first found 21.6
SWL Date From To Est Flow SWL(psi) + SWL(ft)
03-14-2023 21.6 51 1,500 21.6

(11) WELL LOG
Ground Elevation
Material From To
Gravel fill 0 2
Brown clay 2 12
Brown clay w/some gravels 12 15
Gravel w/clay 15 18
Dirty gravel 18 21
Gravel dirty 21 24
Dirty gravel 24 30
Clean gravel & sand 30 33
Cemented gravel 33 42
Dirty gravel 42 50
Large gravel & clay 50 51
Blue clay 51 56

RECEIVED
Jones Drilling Co., Inc.
29400 Santiam Hwy.
Lebanon, OR 97355
1-800-915-8388

Date Started 12-19-2022 Completion 03-14-23

(unbonded) Water Well Constructor Certification
I certify that the work I performed on the construction, deepening, alteration, or abandonment of this well is in compliance with Oregon water supply well construction standards. Materials used and information reported above are true to the best of my knowledge and belief.
License Number 1411 Date 03-17-2023
Signed [Signature]

(bonded) Water Well Constructor Certification
I accept responsibility for the construction, deepening, alteration, or abandonment work performed on this well during the construction dates reported above. All work performed during this time is in compliance with Oregon water supply well construction standards. This report is true to the best of my knowledge and belief.
License Number 1684 Date 03-17-2023
Signed [Signature]
Contact Info (optional) jonesdrilling@hotmail.com

# MARI 70798

Oregon Water Resources Department  
Groundwater Use Recording Mapping Tool

725 Summer St NE, Sale

**Step 1: Search for Well**

**Step 2: Create Well Map**

**Mark Well Point and Create Map:**

Zoom in closer to the well location, if needed.  
Mark the location of the well by either of these two methods:

**A. Drawing on the map using the draw tool**

Click on Icon and draw a point on the map

**B. Type in the GPS Decimal Degrees:**

GPS Latitude:

GPS Longitude:

Mark Point

[Converter](#)

**Results:**

Latitude: 44.846  
Longitude: -123.176


**Complete the form:**

Submitted by:

Address of Well:

City:

Special Notes:

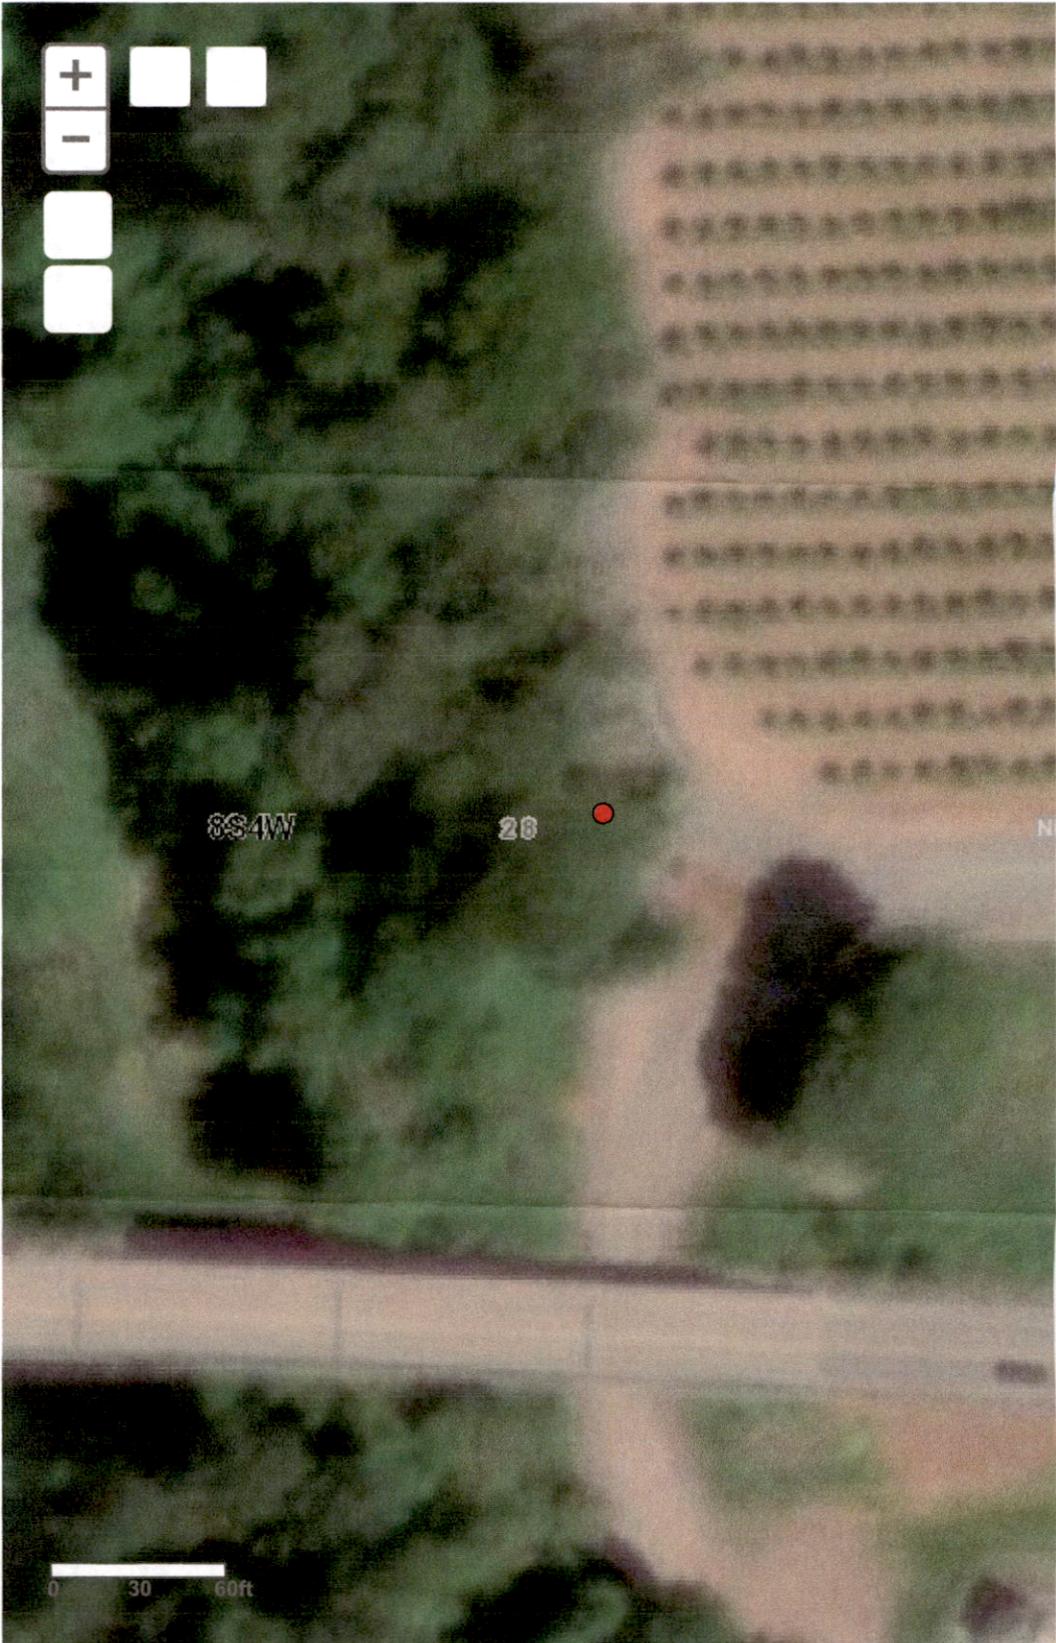

L143506 ↑N

RECEIVED  
MAR 23 2023  
OWRD  
SALEM, OREGON