

STATE ENGINEER
Salem, Oregon

7105
MAR 1951

Well Record

STATE WELL NO. 7/2W-15N
COUNTY Marion
APPLICATION NO. GR-1606

GR- 1558

OWNER: Harry M. Schaffer


MAILING ADDRESS: Rt. 2, Box 622

LOCATION OF WELL: Owner's No. #1

CITY AND STATE: Salem, Oregon

SW 1/4 SW 1/4 Sec. 15 T. 7 S., R. 2 W., W.M.

Bearing and distance from section or subdivision corner 1100' E. & 970' N. from SW cor. Sec. 15

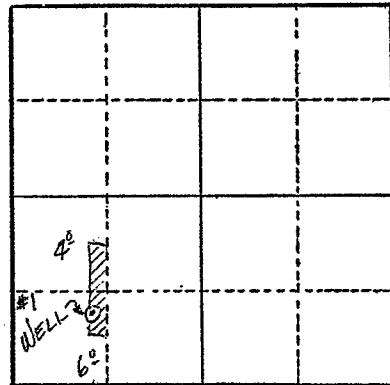

Section 15

Altitude at well

TYPE OF WELL: Drilled Date Constructed 1950

Depth drilled 62' Depth cased 62'

CASING RECORD:

6"

FINISH:

AQUIFERS:

WATER LEVEL:

40'

PUMPING EQUIPMENT: Type Cent. H.P. 2

Capacity 40 G.P.M.

WELL TESTS:

Drawdown 12 ft. after 40 hours G.P.M.

Drawdown ft. after hours G.P.M.

USE OF WATER Irrigation Temp. °F., 19

SOURCE OF INFORMATION GR Record

DRILLER or DIGGER Sneed Bros.

ADDITIONAL DATA:

Log N.A. Water Level Measurements Chemical Analysis Aquifer Test

REMARKS:

Irrigation of 10 acres.