

Marion
4s/w-22d # 7722

Western Modular Homes

Material	From	To
Top soil, brown silty	0	3
Clay, brown soft	3	43
Clay, brown medium	43	62
Clay, brown, soft silty	62	67
Sand, brown silty coarse rusty	67	75
Sand & Gravel, brown medium & fine	75	78
Clay, blue grey sandy dry	78	81
Sand, blue medium	81	87
Sand & some gravel, blue medium	87	92
Gravel & some sand, medium	92	97
Sandstone, green-gray fine	97	104
Gravel, medium w/ some coarse sand (Taking water)	104	113
Gravel, coarse up to 3" loosely cemented w/ some clay, green	113	116
Sandstone, dark green medium coarse	116	117
Sand, black coarse	117	121
Clay, gray	121	123
Clay, blue	123	129
Clay, blue-green fine sandy	129	132
Clay, dark gray	132	134
Clay, green dry hard	134	138
Clay, green fine sandy	138	140
Clay, grayish green	140	158
Clay, gray	158	165
Clay, dark gray soft fine sandy	165	171
Sand, black medium coarse	171	174
Claystone, green hard	174	175
Clay, green	175	177
Sand, coarse	177	178
Clay, green fine sandy	178	180
Clay, gray medium sandy	180	185
Clay, green hard dry	185	188
Clay, gray	188	190
Clay, blue	190	195
Clay, blue green fine sandy	195	201
Clay, blue green	201	212
Clay, grayish green fine sandy w/ wood	212	215
Sandstone, grayish green cemented w/ some wood	215	216
Clay, blue green	216	224
Clay, black hard	224	226
Clay, gray	226	229
Clay, blue green	229	232
Clay, green	232	236
Clay, green fine sandy	236	248
Clay, grey silty	248	253
Clay, grey hard sticky	253	270
Clay, grey fine sandy	270	275
Clay, gray with medium sand	275	284
Clay, gray silty	284	286
Clay, gray w/ medium & fine sand	286	292
Clay, light grey hard	292	293

7722

Marion
4/5/10-2200

Western Modular Homes

Material	From	To
Clay, light gray hard	293	299
Clay, gray silty	299	321
Clay, dark gray sticky & hard	321	327
Clay, gray fine silty	327	352
Sand, gray medium w/ some clay	352	354
Clay, brown silty	354	356
Clay, gray sticky	356	368
Clay, dark gray	368	369
Sand, gray medium w/ some clay (some wood chips)	369	373
Clay, gray sticky	373	381
Clay, light green	381	386
Clay, light green & gray	386	389
Clay, light green	389	393

(5) Casing Installed:


12" Diam. from +3'6"	to 291'9 $\frac{1}{2}$ "	Gage. 375
12" Diam. from 291'9 $\frac{1}{2}$ "	to 331'11 $\frac{1}{2}$ "	Gage. 330
12" Diam. from 331'11 $\frac{1}{2}$ "	to 373'11 $\frac{1}{2}$ "	Gage. 375
12" Diam. from 373'11 $\frac{1}{2}$ "	to 394'2 $\frac{1}{2}$ "	Gage. 330
6" Diam. from +1'9"	to 32'4"	Gage. 250 (gravel feed)

Well Test
for
Western Modular Homes
at
Lakewood Estates

SCHNEIDER EQUIPMENT, INC.
STAR ROUTE, BOX 97 - (503) 633-2666
ST. PAUL, OREGON 97137

Mar 15/1w-22

Static 43' immediately before test

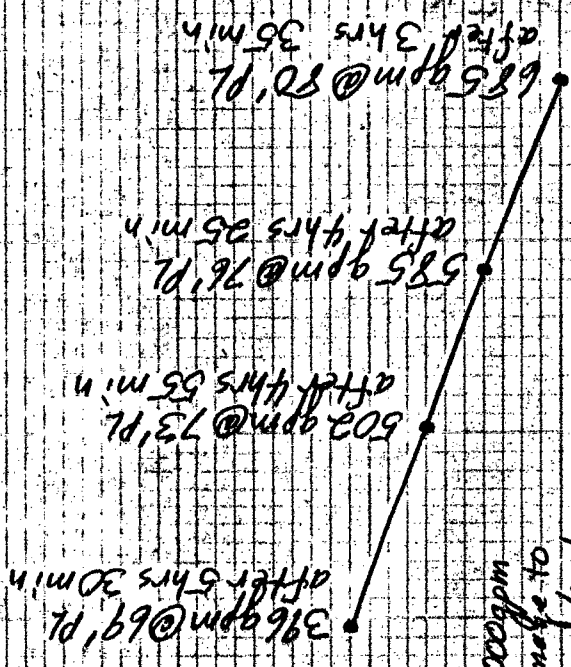

Note: Well will produce over 1000gpm but because of extensive damage to the test pump bowl assy during development of the well, higher gpm readings than these reported were unable to be taken accurately.

30
40
50
60
70
80
90

Water Level Below Ground (feet)

Gallons per Minute (gpm)

0 100 200 300 400 500 600 700 800 900 1000