

STATE OF OREGON
WATER SUPPLY WELL REPORT

WESTERBERG DRILLING INC.
PO BOX 1228

WELL I.D. LABEL# 151660
START CARD # 1073849
ORIGINAL LOG #

(as required by ORS 537.545 & 537.765 and OAR 690-205-0210)

(1) LAND OWNER Owner Well I.D. **MOLALLA, OR 97038**
First Name John Appel & Last Name Annie Mock
Company _____
Address 17049 Mountain View Lane
City Woodburn State OR Zip 97071

(9) LOCATION OF WELL (legal description)
County MARION Twp 5 S N/S Range 2 W E/W WM
Sec 02 SW 1/4 of the NE 1/4 Tax Lot 900
Tax Map Number _____ Lot _____
Lat _____ " or 45.16790 DMS or DD
Long _____ " or -122.89569 DMS or DD
 Street address of well Nearest address

(2) TYPE OF WORK New Well Deepening Conversion
 Alteration (complete 2a & 10) Abandonment (complete 5a)

(2a) PRE-ALTERATION
Dia + From To Gauge Stl Plstc Wld Thrd
Casing: _____
Material From To Amt sacks/lbs
Seal: _____

(3) DRILL METHOD
 Rotary Air Rotary Mud Cable Auger Cable Mud
 Reverse Rotary Other _____

(4) PROPOSED USE Domestic Irrigation Community
 Industrial/ Commercial Livestock Dewatering
 Thermal Injection Other _____

(5) BORE HOLE CONSTRUCTION Special Standard (Attach copy)
Depth of Completed Well 208 ft.

17200 Harmony Lane, Woodburn

(10) STATIC WATER LEVEL
Date SWL(psi) + SWL(ft)
Existing Well / Pre-Alteration _____
Completed Well 6-7-24 _____
Flowing Artesian? Dry Hole?

WATER BEARING ZONES Depth water was first found 73

SWL Date	From	To	Est Flow	SWL(psi)	+ SWL(ft)
6-3-24	73	85	dnm		dnm
6-3-24	124	129	40		38
6.3.24	139	150	dnm		dnm
6-7-24	150	176	50		38
6-7-24	182	185	dnm		38

BORE HOLE

Dia	From	To	Material	From	To	Amt	sacks/lbs
10	0	60	Bentonite	0	15	7	S
6	60	208				Calculated	6.3
			Cement	15	60	32	S
						Calculated	12.5

How was seal placed: Method A B C D E
 Other bent prd & probed
Backfill placed from _____ ft. to _____ ft. Material _____
Filter pack from 124 ft. to 208 ft. Material silica sand Size 8/12
Seal Placement Begin Date 6-7-24 Begin Time 09:30

(5a) ABANDONMENT USING UNHYDRATED BENTONITE
Proposed Amount P Actual Amount P

(6) CASING/LINER

Casing	Liner	Dia	+ From	To	Gauge	Stl	Plstc	Wld	Thrd
<input checked="" type="checkbox"/>	<input checked="" type="checkbox"/>	6	2	164	250	<input checked="" type="checkbox"/>	<input checked="" type="checkbox"/>	<input checked="" type="checkbox"/>	<input checked="" type="checkbox"/>
<input checked="" type="checkbox"/>	<input checked="" type="checkbox"/>	4	124	165	200	<input checked="" type="checkbox"/>	<input checked="" type="checkbox"/>	<input checked="" type="checkbox"/>	<input checked="" type="checkbox"/>
<input checked="" type="checkbox"/>	<input checked="" type="checkbox"/>	4	175	195	200	<input checked="" type="checkbox"/>	<input checked="" type="checkbox"/>	<input checked="" type="checkbox"/>	<input checked="" type="checkbox"/>
<input checked="" type="checkbox"/>	<input checked="" type="checkbox"/>	4	205	208	200	<input checked="" type="checkbox"/>	<input checked="" type="checkbox"/>	<input checked="" type="checkbox"/>	<input checked="" type="checkbox"/>

Shoe Inside Outside Other Location of shoe(s) 208
Temp casing Yes Dia 10 From 1 To 55

(7) PERFORATIONS/SCREENS
Perforations Method _____
Screens Type v wire Material stainless steel

Perf Screen	Casing/ Liner	Dia	From	To	Scr/slot width	Slot length	# of slots	Tele/ pipe size
<input checked="" type="checkbox"/>	<input checked="" type="checkbox"/>	4	165	175	.040			4
<input checked="" type="checkbox"/>	<input checked="" type="checkbox"/>	4	195	205	.040			4

(8) WELL TESTS: Minimum testing time is 1 hour
 Pump Bailer Air Flowing Artesian
Yield gal/min 100 Drawdown _____ Drill stem/Pump depth 115 Duration (hr) 1
Temperature 56 °F Lab analysis Yes By _____
Water quality concerns? Yes (describe below) TDS amount 170 ppb
From _____ To _____ Description _____ Amount _____ Units _____

(11) WELL LOG Ground Elevation _____

Material	From	To
soil	0	2
clay brown medium	2	25
clay grey sticky	25	55
silt grey	55	73
sand black	73	85
clay grey sticky	85	94
sand grey	94	103
clay grey	103	117
sand & gravel brown	117	129
packed silt & gravel grey	129	135
silt grey	135	139
sand black & brown	139	150
sand black	150	176
gravel with silt	176	182
sand black	182	185
hard pan with silt grey	185	194
sand black	194	207
clay green	207	208

Construction Begin Date 5-30-24 Bcgin Time 16:30 End Date 6-7-24

(unbonded) Water Well Constructor Certification
I certify that the work I performed on the construction, deepening, alteration, or abandonment of this well is in compliance with Oregon water supply well construction standards. Materials used and information reported above are true to the best of my knowledge and belief.
License Number 1258 Date 6-13-24

Signed [Signature] RECEIVED

(bonded) Water Well Constructor Certification
I accept responsibility for the construction, deepening, alteration, or abandonment work performed on this well during the construction dates reported above. I performed during this time is in compliance with Oregon water supply well construction standards. This report is true to the best of my knowledge and belief.
License Number 688 Date 6-13-24

Signed [Signature] JUN 24 2024
Contact Info (optional) _____

WATER SUPPLY WELL REPORT - continuation page

WESTERBERG DRILLING INC. PO BOX 1228

WELL I.D. LABEL# L 151660 START CARD # 1073849 ORIGINAL LOG #

MOLALLA, Water Quality Concerns

(2a) PRE-ALTERATION

Table with columns: Dia, +, From, To, Gauge, Stil, Plstc, Wld, Thrd. Includes a diagram of a well casing section.

(5) BORE HOLE CONSTRUCTION

Table with columns: BORE HOLE (Dia, From, To), SEAL (Material, From, To), Amt, sacks/lbs. Includes 'Calculated' entries.

FILTER PACK

Table with columns: From, To, Material, Size.

(6) CASING/LINER

Table with columns: Casing Liner, Dia, +, From, To, Gauge, Stil, Plstc, Wld, Thrd. Includes a diagram of casing sections.

(7) PERFORATIONS/SCREENS

Table with columns: Perf/Screen, Casing/Liner, Dia, From, To, Scrn/slot width, Slot length, # of slots, Tele/pipe size.

(8) WELL TESTS: Minimum testing time is 1 hour

Table with columns: Yield gal/min, Drawdown, Drill stem/Pump depth, Duration (hr).

Table with columns: From, To, Description, Amount, Units.

(10) STATIC WATER LEVEL

Table with columns: SWL Date, From, To, Est Flow, SWL(psi), + SWL(ft).

(11) WELL LOG

Large table with columns: Material, From, To.

Table for Name of person(s) who assisted with construction and Traine License # / Helper #. Includes Assistant Name, Type, #.

Comments/Remarks: 56 sacks of 8/12 sand. Received JUN 24 2024 OWRD

Step 1: Search for Well

Step 2: Create Well Map

Mark Well Point and Create Map:

Zoom in closer to the well location, if needed.
Mark the location of the well by either of these 1

A. Drawing on the map using the draw tool

Click on Icon and draw a point on the map

B. Type in the GPS Decimal Degrees:

GPS Latitude:

GPS Longitude:

Mark Point Clear Point

[Converter](#)

Results:

Latitude: 45.16790 Longitude: -122.89569


Complete the form:

Submitted by:

Address of Well:

City:

Special Notes:

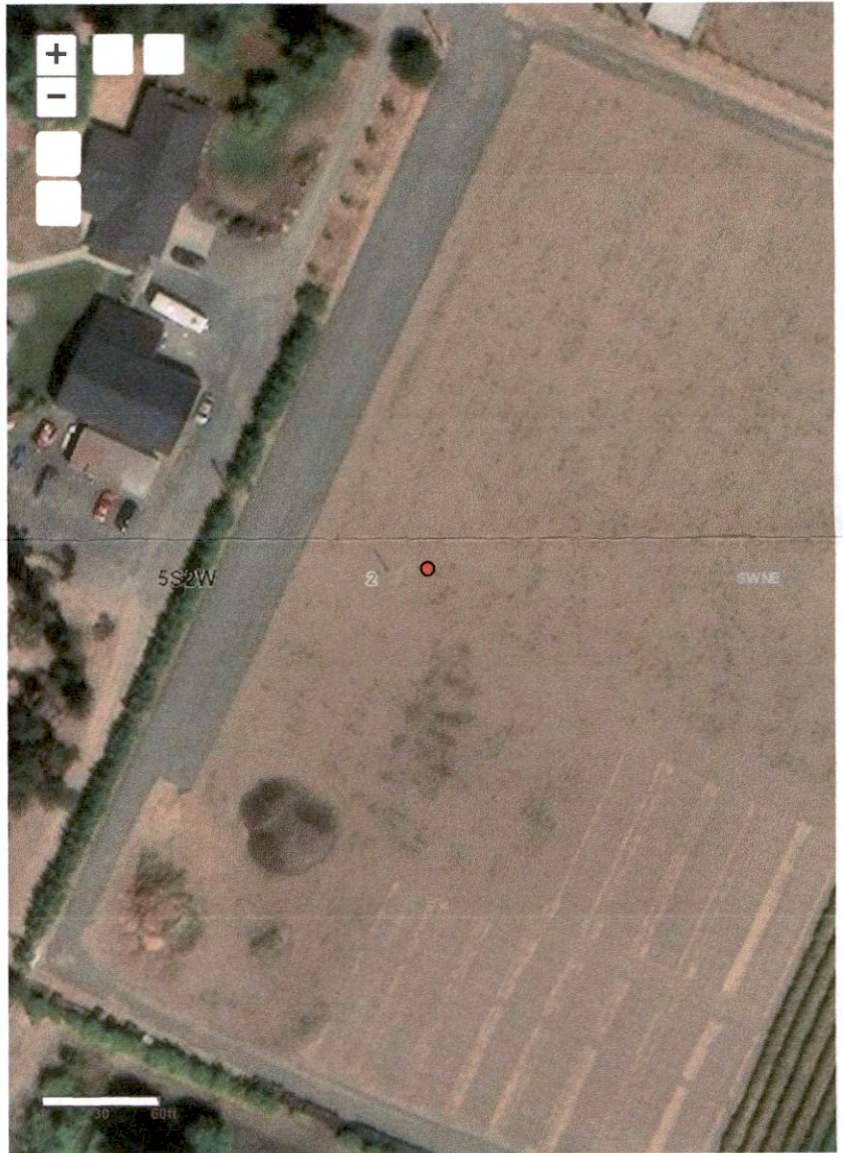

Received
11/24/2024
OWRD