

STATE ENGINEER  
Salem, Oregon

MAR 7 1933

# Well Record

STATE WELL NO. 7/2W-16  
COUNTY Marion  
APPLICATION NO. GR-1485

GR- 1434


OWNER: Vernon B. Van Cleave

MAILING ADDRESS: 6560 Lardon Lane

LOCATION OF WELL: Owner's No.

CITY AND STATE: Salem, Oregon

NE 1/4 NW 1/4 Sec. 16 T. 7 S., R. 2 W., W.M.

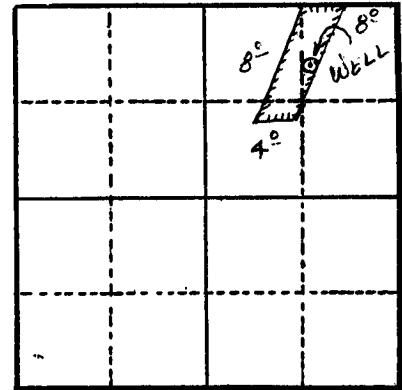

Bearing and distance from section or subdivision corner 1450' E. & 800' S. from NE cor. Sec. 16

Section 16

Altitude at well

TYPE OF WELL: Drilled Date Constructed 1953

Depth drilled 143' Depth cased 143'

### CASING RECORD:

8"

### FINISH:

Perforated from 109' to 112'  
" " from 133' to 139'

### AQUIFERS:

### WATER LEVEL:

21'

PUMPING EQUIPMENT: Type F. M. turbine H.P. 10

Capacity 250 G.P.M.

### WELL TESTS:

Drawdown 20 ft. after 700 hours G.P.M.

Drawdown ft. after hours G.P.M.

USE OF WATER Irrigation Temp. °F. 19

SOURCE OF INFORMATION GR Record

DRILLER or DIGGER Harty Bros.

### ADDITIONAL DATA:

Log Water Level Measurements Chemical Analysis Aquifer Test

### REMARKS:

Log: Clay & sand 0 to 64'  
Black sand 64' to 67'  
Gravel 67' to 73'  
Cement gravel 73' to 132'  
Black sand & gravel 132' to 143'

Irrigation of 20 acres.