

STATE ENGINEER
Salem, Oregon

7161
MAY 17 1945

Well Record


STATE WELL NO. 7/2W-17
COUNTY Marion
APPLICATION NO. GR-330

OWNER: M. E. Clapper MAILING ADDRESS: 5090 Silverton Road

LOCATION OF WELL: Owner's No. CITY AND STATE: Salem, Oregon

..... 1/4 1/4 Sec. 17 T. 7 S., R. 2 W., W.M.

Bearing and distance from section or subdivision corner

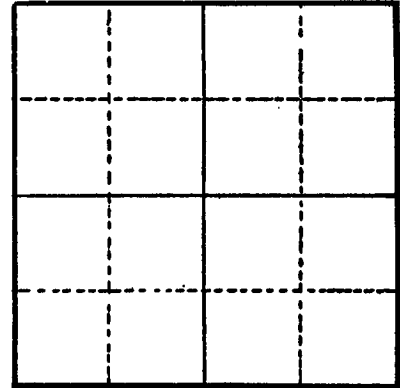

Section

Altitude at well 195 feet

TYPE OF WELL: Drilled Date Constructed 1945

Depth drilled 172 feet Depth cased 172 feet

CASING RECORD:

10-inch

FINISH:

AQUIFERS:

WATER LEVEL:

12 to 16 feet

PUMPING EQUIPMENT: Type Berkeley H.P. 5
Capacity G.P.M.

WELL TESTS:

Drawdown ft. after hours G.P.M.
Drawdown ft. after hours G.P.M.

USE OF WATER Irrigation Temp. °F., 19

SOURCE OF INFORMATION GR-380

DRILLER or DIGGER

ADDITIONAL DATA:

Log no Water Level Measurements Chemical Analysis Aquifer Test

REMARKS: