

STATE ENGINEER
Salem, Oregon

MAR 21 7165

Well Record

STATE WELL NO. 7/2W-17C
COUNTY Marion
APPLICATION NO. GR-3071

OWNER: Harlan C. Selby


MAILING ADDRESS: 3195 Walker Road

LOCATION OF WELL: Owner's No.

CITY AND STATE: Salem, Oregon

NE 1/4 NW 1/4 Sec. 17 T. 7 N. R. 2 W., W.M.

Bearing and distance from section or subdivision corner N. 8° 40' E. 28.5 chs. and 100 ft. W. from SE corner W. J. Herron DLC 48

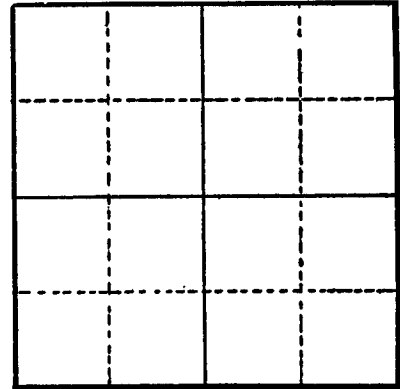

Section

Altitude at well

TYPE OF WELL: drilled Date Constructed 1949

Depth drilled 92' Depth cased 92'

CASING RECORD:

6"

FINISH:

AQUIFERS:

WATER LEVEL:

25'

PUMPING EQUIPMENT: Type Deep Well Jet H.P. 2
Capacity 40 G.P.M.

WELL TESTS:

Drawdown ft. after hours G.P.M.
Drawdown ft. after hours G.P.M.

USE OF WATER Irrigation Temp. °F. 19

SOURCE OF INFORMATION GR-2874

DRILLER or DIGGER Stadeli Silverton, Oregon

ADDITIONAL DATA:

Log Water Level Measurements Chemical Analysis Aquifer Test

REMARKS: