

STATE ENGINEER  
Salem, Oregon

7166  
MAR 21 1949


# Well Record

STATE WELL NO. 7/2W-17C  
COUNTY MARION  
APPLICATION NO. GR-2416

OWNER: Walter A. Zwenke  
MAILING ADDRESS: 3135 Walker Road

LOCATION OF WELL: Owner's No.  
CITY AND STATE: SALEM, OREGON

NE 1/4 NW 1/4 Sec. 17 T. 7 N S., R. 2 W., W.M.  
Bearing and distance from section or subdivision corner 2300' E. & 1300' S.

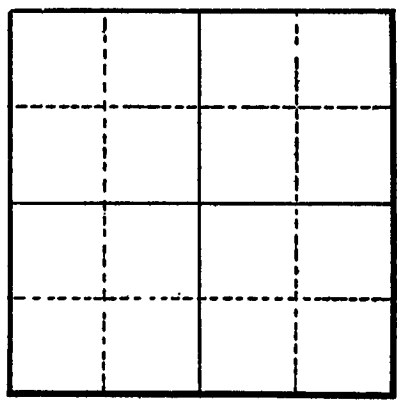

Altitude at well

TYPE OF WELL: Drilled Date Constructed 1949  
Depth drilled 113 Depth cased 113

Section

### CASING RECORD:

6-inch

### FINISH:

### AQUIFERS:

### WATER LEVEL:

20-feet

PUMPING EQUIPMENT: Type Fairbanks Morse Turbine H.P. 1/2  
Capacity G.P.M.

### WELL TESTS:

Drawdown ft. after hours G.P.M.  
Drawdown ft. after hours G.P.M.

USE OF WATER Irrigation Temp. °F. 19

SOURCE OF INFORMATION GR-2296

DRILLER or DIGGER R. Stadel

### ADDITIONAL DATA:

Log Water Level Measurements Chemical Analysis Aquifer Test

### REMARKS: