

7167
MARION
Mari

Well Record

OWNER: William P. Phillips


MAILING ADDRESS: 3103 Walker Road N. E.

LOCATION OF WELL: Owner's No. _____

CITY AND STATE: Salem, Oregon

SE $\frac{1}{4}$ NW $\frac{1}{4}$ Sec. 17 T. 7 N. S., R. 2 W., W.M.

Bearing and distance from section or subdivision corner 2300' E. and 1400' S.

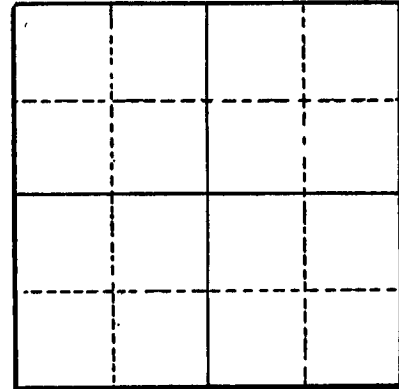

Section _____

Altitude at well _____

TYPE OF WELL: Drilled Date Constructed 1948

Depth drilled 65 Depth cased _____

CASING RECORD:

6-Inch

FINISH:

AQUIFERS:

WATER LEVEL:

27-Feet

PUMPING EQUIPMENT: Type F. M. Jet H.P. _____
Capacity 30 G.P.M.

WELL TESTS:

Drawdown _____ ft. after _____ hours _____ G.P.M.
Drawdown _____ ft. after _____ hours _____ G.P.M.

USE OF WATER Irrigation Temp. _____ °F. _____, 19____
SOURCE OF INFORMATION GR-2133

DRILLER or DIGGER

ADDITIONAL DATA:

Log _____ Water Level Measurements _____ Chemical Analysis _____ Aquifer Test _____

REMARKS: