

STATE ENGINEER  
Salem, Oregon


7171  
m... ..

# Well Record

STATE WELL NO. 7/2W-17G  
COUNTY Marion  
APPLICATION NO. GR-3539

OWNER: Dale Herigstad  
LOCATION OF WELL: Owner's No. ....  
Mailing ADDRESS: 4920 Silverton Road  
CITY AND STATE: Salem, Oregon

N. E.  
NW 1/4 NW 1/4 Sec. 17 T. 7 S., R. 2 W., W.M.  
Bearing and distance from section or subdivision  
corner S. 75° 44' E. 639.70' from NW corner  
Sec. 17

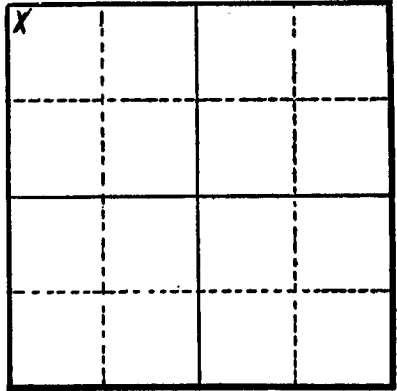

Altitude at well .....

TYPE OF WELL: Drilled Date Constructed Aug., 1948

Depth drilled 65 ft. Depth cased 65

Section 17

### CASING RECORD:

6 inch casing set to 65 feet

### FINISH:

None

### AQUIFERS:

Sand & Rock

### WATER LEVEL:

20 feet below surface

PUMPING EQUIPMENT: Type Universal H.P. 2  
Capacity 10 G.P.M.

### WELL TESTS:

Drawdown 2 ft. after ..... hours 20 G.P.M.  
Drawdown ..... ft. after ..... hours ..... G.P.M.

USE OF WATER Irrigation Temp. °F. ...., 19

SOURCE OF INFORMATION Well Registration Statement

DRILLER or DIGGER .....

ADDITIONAL DATA:  
Log  Water Level Measurements ..... Chemical Analysis ..... Aquifer Test .....

### REMARKS:

Log:	Thickness	Depth to Bottom
Clay and top soil	40 ft.	25
Sand	6	19
Blue Clay	15	4
Sand and rock (gravel)	4' to bottom of well	