

STATE ENGINEER
Salem, Oregon

MAR 17 1952

Well Record

STATE WELL NO. 4/LW-22H(1)
COUNTY Marion
APPLICATION NO.

OWNER: Irl Davis


MAILING ADDRESS:

LOCATION OF WELL: Owner's No.

CITY AND STATE:

..... 1/4 1/4 Sec. T. N. E. S, R. W., W.M.

Bearing and distance from section or subdivision corner

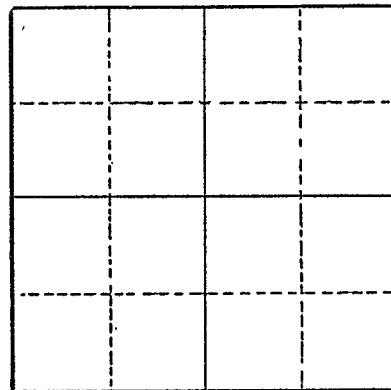

Section

Altitude at well 175

TYPE OF WELL: Drilled Date Constructed 1952

Depth drilled 144 Depth cased 133

CASING RECORD:

6 inch

FINISH:

Casing perforated 120-133

AQUIFERS:

Sand and gravel from 116 to 132

Large, blue gravel from 144

WATER LEVEL:

48 feet

PUMPING EQUIPMENT: Type Turbine H.P. 15
Capacity G.P.M.

WELL TESTS:

Drawdown ft. after hours G.P.M.

Drawdown ft. after hours G.P.M.

USE OF WATER Irrigation--47 acres Temp. °F., 19

SOURCE OF INFORMATION USGS

DRILLER or DIGGER

ADDITIONAL DATA:

Log Water Level Measurements Chemical Analysis Aquifer Test

REMARKS:

