

STATE ENGINEER
Salem, Oregon

MARI. 722

Well Record

STATE WELL NO. 4/1W-22J(1)
COUNTY Marion
APPLICATION NO. GR-1454

GR- 1403

OWNER: William J. Chase


MAILING ADDRESS: Rt. 1, Box 275

LOCATION OF WELL: Owner's No.

CITY AND STATE: Aurora, Oregon

NE 1/4 SE 1/4 Sec. 22 T. 4 S., R. 1 W., W.M.

Bearing and distance from section or subdivision
corner 2170' N. & 1250' W. from SE cor. Sec. 22.

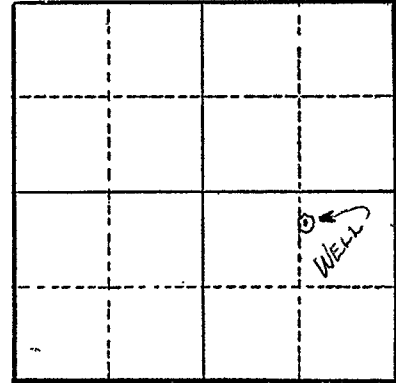

Section 22

Altitude at well 170

TYPE OF WELL: Drilled Date Constructed 1948

Depth drilled 113.5' Depth cased 113'

CASING RECORD:
6"

FINISH:

AQUIFERS:

WATER LEVEL:
51'

PUMPING EQUIPMENT: Type Jacuzzi jet H.P. 5
Capacity 60 G.P.M.

WELL TESTS:
Drawdown 59 ft. after 95 hours G.P.M.
Drawdown ft. after hours G.P.M.

USE OF WATER Manufacturing Temp. °F., 19.

SOURCE OF INFORMATION GR Record

DRILLER or DIGGER Miller

ADDITIONAL DATA:
Log N.A. Water Level Measurements Chemical Analysis Aquifer Test

REMARKS: