

STATE ENGINEER  
Salem, Oregon

MARI 723

# Well Record

STATE WELL NO. 4/W - 22K1  
COUNTY MARION  
APPLICATION NO. GR-1988

OWNER: Leslie Eppers


MAILING ADDRESS: Rt. 1, Box 273

LOCATION OF WELL: Owner's No.

CITY AND STATE: Aurora, Oregon

NW 1/4 SE 1/4 Sec. 22 T. 4 N. S., R. 1 E. W., W.M.

Bearing and distance from section or subdivision corner 450' N. & 100' W.

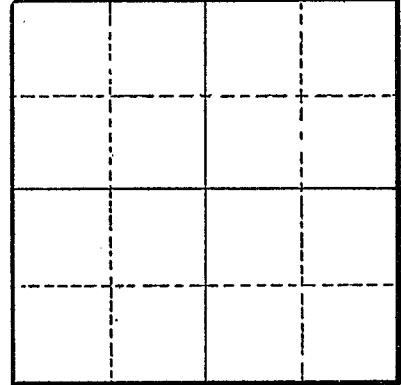

Section

Altitude at well 17.5

TYPE OF WELL: Dug Date Constructed 1952

Depth drilled 145 Depth cased 130

### CASING RECORD:

12-inch

### FINISH:

Zig zag Mill knife 24 holes from 115' to 117'  
Zig zag Mill knife 22 holes from 118' to 123'

### AQUIFERS:

Clay

### WATER LEVEL:

60-feet, 1952

PUMPING EQUIPMENT: Type Peerless Turbine H.P. 30  
Capacity 475 G.P.M.

### WELL TESTS:

Drawdown 110 ft. after Pumping 700 hours G.P.M.  
Drawdown ft. after hours G.P.M.

USE OF WATER Irrigation - 70 acres Temp. °F., 19.

SOURCE OF INFORMATION GR-1919

DRILLER or DIGGER T. J. Miller

### ADDITIONAL DATA:

Log  Water Level Measurements  Chemical Analysis  Aquifer Test

### REMARKS:

