

STATE ENGINEER  
Salem, Oregon

7258  
MARKI

# Well Record

STATE WELL NO. 7/2W-18B  
COUNTY MARION  
APPLICATION NO. GR-2899

OWNER: F. M. Chapman


MAILING ADDRESS: 4345 Silverton Rd.

LOCATION OF WELL: Owner's No.

CITY AND STATE: Salem, Oregon

NW 1/4 NE 1/4 Sec. 18 T. 7 S., R. 2 W., W.M.

Bearing and distance from section or subdivision corner

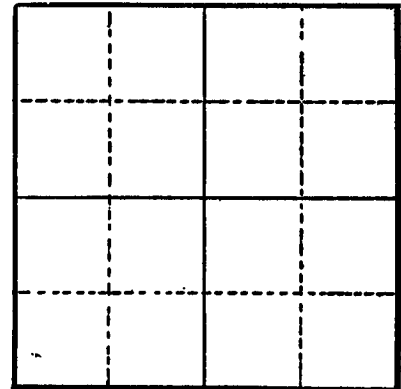

Section

Altitude at well

TYPE OF WELL: drilled Date Constructed 1945

Depth drilled 107 Depth cased 90

### CASING RECORD:

6-inch

### FINISH:

### AQUIFERS:

### WATER LEVEL:

22-feet

PUMPING EQUIPMENT: Type Jet H.P. 1  
Capacity 30 G.P.M.

### WELL TESTS:

Drawdown ? ft. after hours Pumping 50 G.P.M.  
Drawdown ft. after hours G.P.M.

USE OF WATER Irrigation Temp. °F., 19

SOURCE OF INFORMATION GR-2728

DRILLER or DIGGER Fred Wymore

### ADDITIONAL DATA:

Log Water Level Measurements Chemical Analysis Aquifer Test

### REMARKS: