

STATE ENGINEER
Salem, Oregon

7259
MAP 21

OBSERVATION WELL
Well Record

STATE WELL NO. 7/2W-18B(1)
COUNTY Marion
APPLICATION NO. GR-234


OWNER: ALBA KEEN
Emery Alderman

MAILING ADDRESS:

LOCATION OF WELL: Owner's No.

CITY AND STATE: Salem, Oregon

NW 1/4 NE 1/4 Sec. 18 T. 7 S., R. 2 W., W.M.

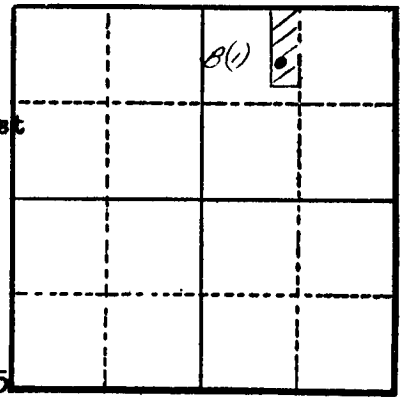

Bearing and distance from section or subdivision corner
709 feet South and 161 feet West at the most easterly NE Savage DLC

Altitude at well 185 feet

TYPE OF WELL: Drilled Date Constructed July 11, 1955

Depth drilled 117 feet Depth cased unk

Section 18

CASING RECORD:

8-inch

FINISH:

AQUIFERS:

WATER LEVEL:

22 feet

PUMPING EQUIPMENT: Type Berkeley Jet H.P. 5 GE
Capacity 60 G.P.M.

WELL TESTS:

Drawdown ft. after hours G.P.M.
Drawdown ft. after hours G.P.M.

USE OF WATER Irrigation Temp. °F., 19

SOURCE OF INFORMATION GR-213

DRILLER or DIGGER Emil Beier, Salem

ADDITIONAL DATA:

Log no Water Level Measurements Chemical Analysis Aquifer Test

REMARKS: