

STATE ENGINEER
Salem, Oregon

MAR 31 7359

Well Record


STATE WELL NO. 7/2W-19A
COUNTY Marion
APPLICATION NO. GR-4194

OWNER: Alfred A. Baillie & Dena J. Baillie ADDRESS: 1850 Birchwood Drive

LOCATION OF WELL: Owner's No. CITY AND STATE: Salem, Oregon

NE 1/4 NE 1/4 Sec. 19 T. 7 S., R. 2 W., W.M.

Bearing and distance from section or subdivision
corner 16 chs. S. & 7 chs. E. from SW Cor. Herron
DLC 53

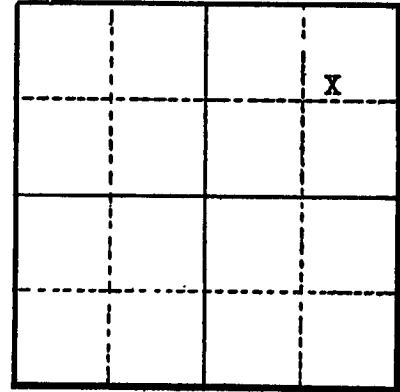

Section 19

Altitude at well

TYPE OF WELL: Drilled Date Constructed 1948

Depth drilled 60 ft. Depth cased

CASING RECORD:

6 inch casing

FINISH:

AQUIFERS:

WATER LEVEL:

PUMPING EQUIPMENT: Type Universal Mfg. Co. H.P. 1 1/2
Capacity 40 G.P.M.

WELL TESTS:

Drawdown ft. after hours G.P.M.
Drawdown ft. after hours G.P.M.

USE OF WATER Irrigation Temp. °F. 19

SOURCE OF INFORMATION Wall Registration Statement Cert. # GR-3749

DRILLER or DIGGER

ADDITIONAL DATA:

Log Water Level Measurements Chemical Analysis Aquifer Test

REMARKS: