

STATE ENGINEER
Salem, Oregon

MAR 7 3 1966
Well Record


STATE WELL NO. 7/2W-19H
COUNTY Marion
APPLICATION NO. GR-3875

OWNER: Joseph P. Cojad
MAILING ADDRESS: 1728 Burchwood Drive NE

LOCATION OF WELL: Owner's No. CITY AND STATE: Salem, Oregon

SE 1/4 NE 1/4 Sec. 19 T. 7 S., R. 2 W., W.M.

Bearing and distance from section or subdivision corner 500' W. & 1220' N. from E 1/4 Cor.

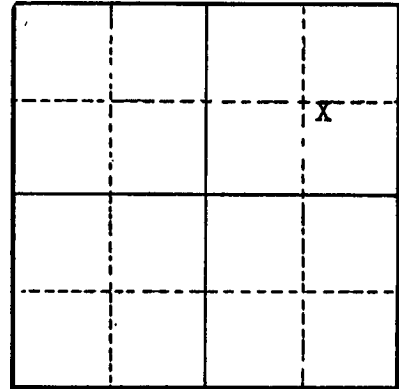

Section 19

Altitude at well

TYPE OF WELL: Drilled Date Constructed 1940

Depth drilled 102 ft. Depth cased 102 ft.

CASING RECORD:

6 inch casing set to 102 feet

FINISH:

6 perforations per foot 1/4" x 2" from 55 to 102 feet

AQUIFERS:

WATER LEVEL:

20 feet below surface

PUMPING EQUIPMENT: Type Berkeley turbine H.P. 5
Capacity 100 G.P.M.

WELL TESTS:

Drawdown 30 ft. after 100 hours G.P.M.

Drawdown ft. after hours G.P.M.

USE OF WATER Irrigation Temp. °F., 19

SOURCE OF INFORMATION Well Registration Statement Cert. # GR-3525

DRILLER or DIGGER Marion E. West

ADDITIONAL DATA:

Log Water Level Measurements Chemical Analysis Aquifer Test

REMARKS: