

STATE ENGINEER
Salem, Oregon

7367
MA 7/21

Well Record

STATE WELL NO. 7/2W-19H(1)
COUNTY Marion
APPLICATION NO. GR-115

OWNER: Earl B. Huckstep


MAILING ADDRESS: 4725 Swiegle Road

LOCATION OF WELL: Owner's No. #1

CITY AND STATE: Salem, Oregon

SE 1/4 NE 1/4 Sec. 19 T. 7 S., R. 2 W., W.M.

Bearing and distance from section or subdivision
corner 960 feet East and 415 feet North of
the SW corner, John C. Harren DLC 53

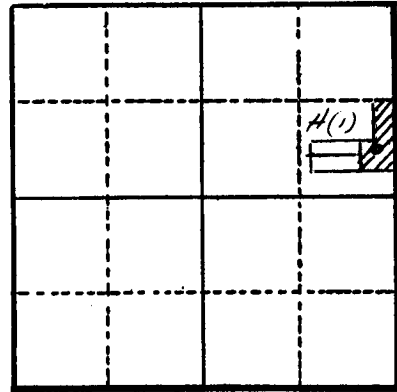

Section 19

Altitude at well 200 feet interpolated

TYPE OF WELL: Drilled Date Constructed Sept. 1951

Depth drilled 120 feet Depth cased unk

CASING RECORD:

FINISH:

AQUIFERS:

WATER LEVEL:

20 feet below land surface Sept. 1951

PUMPING EQUIPMENT: Type Berkeley Turbine 3" H.P. 5
Capacity 160 G.P.M.

WELL TESTS:

Drawdown 60 ft. after 400 hours G.P.M.
Drawdown ft. after hours G.P.M.

USE OF WATER Irrigation 7.5 Temp. °F., 19
SOURCE OF INFORMATION GR-106

DRILLER or DIGGER

ADDITIONAL DATA:

Log no Water Level Measurements Chemical Analysis Aquifer Test

REMARKS: