

STATE ENGINEER  
Salem, Oregon

7375  
MARI

# Well Record

STATE WELL NO. 7/2W-19N(1)  
COUNTY Marion  
APPLICATION NO. GR-766

OWNER: A. W. Thelma Bagley


MAILING ADDRESS: 3765 Center Street

LOCATION OF WELL: Owner's No. # 1

CITY AND STATE: Salem, Oregon

SW 1/4 SW 1/4 Sec. 19 T. 7 S., R. 2 W., W.M.

Bearing and distance from section or subdivision corner 60 feet North and 250 feet East from SW corner, Section 19

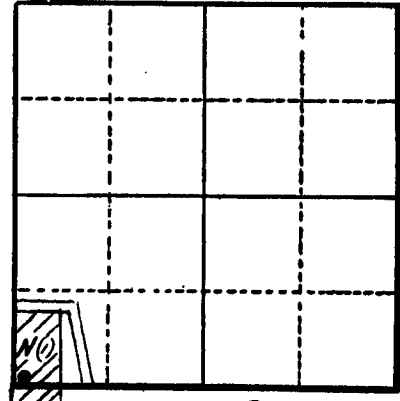

Altitude at well 204 feet interpolated

TYPE OF WELL: Drilled Date Constructed 1942

Depth drilled 125 feet Depth cased 125 feet

Section 19

### CASING RECORD:

8-inch steel from 0 to 125 feet

### FINISH:

mill knife slots from 84 1/2

### AQUIFERS:

### WATER LEVEL:

5 feet

PUMPING EQUIPMENT: Type Deming turbine pump H.P. 10

Capacity 200 G.P.M.

### WELL TESTS:

Drawdown ft. after hours G.P.M.

Drawdown ft. after hours G.P.M.

USE OF WATER Irrigation Temp. °F., 19

SOURCE OF INFORMATION GR-741

DRILLER or DIGGER Sneed

### ADDITIONAL DATA:

Log <sup>x</sup> Water Level Measurements Chemical Analysis Aquifer Test

### REMARKS:

Sandstone (black) 0 45 45  
Cement gravel 45 125 80  
Water bearing at 84 feet