

STATE ENGINEER  
Salem, Oregon

7378  
M. MAKI

# Well Record

GR- 1688

STATE WELL NO. 7/2W-19Q  
COUNTY Marion  
APPLICATION NO. GR- 1741

OWNER: Serra Catholic High School


MAILING ADDRESS: 1040 Lancaster Dr. NE

LOCATION OF WELL: Owner's No. #2

CITY AND STATE: Salem, Oregon

SW 1/4 SE 1/4 Sec. 19 T. 7 S., R. 2 W., W.M.

Bearing and distance from section or subdivision  
corner 120' E. & 720' N. from St. cor. Sec. 19

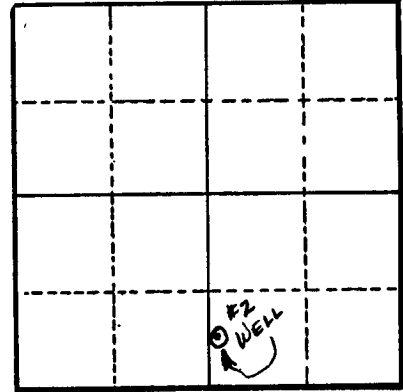

Section 19

Altitude at well 207'

TYPE OF WELL: Drilled Date Constructed 1955

Depth drilled 93' Depth cased 93'

### CASING RECORD:

8"

### FINISH:

Perforated with 5/16" x 2 1/2" slots (10/ft.) from 57 to 64 ft. & from 80 to 91 ft.

### AQUIFERS:

### WATER LEVEL:

12'

PUMPING EQUIPMENT: Type ..... H.P. 10  
Capacity 200 G.P.M.

### WELL TESTS:

Drawdown 31 ft. after ..... hours 102 G.P.M.  
Drawdown 39 ft. after ..... hours 200 G.P.M.

USE OF WATER Irrigation & Domestic Temp. °F. 19

SOURCE OF INFORMATION GR Record

DRILLER or DIGGER J. A. Sneed & Son

### ADDITIONAL DATA:

Log  Water Level Measurements ..... Chemical Analysis ..... Aquifer Test .....

### REMARKS:

Irrigation of about 20 acres.

