

STATE ENGINEER
Salem, Oregon

Well Record

STATE WELL NO. 7/2W-20E
COUNTY Marion
APPLICATION NO. GR-3047

OWNER: Albert Joseph Patz


MAILING ADDRESS: 4795 Swegle Road

LOCATION OF WELL: Owner's No. #1

CITY AND STATE: Salem, Oregon

SW 1/4 NW 1/4 Sec. 20 T. 7 N. S. R. 2 W., W.M.

Bearing and distance from section or subdivision corner 4.2 Chs. E. & 32.2 chs. S.

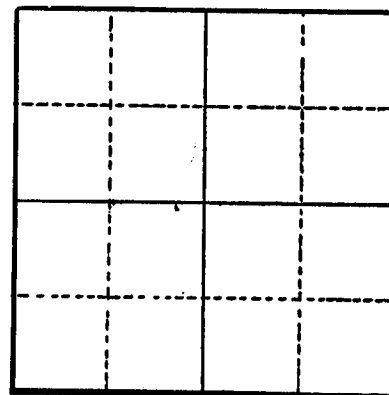

Section

Altitude at well

TYPE OF WELL: Driven Date Constructed 1951

Depth drilled 43 Depth cased 43

CASING RECORD:

2-inch

FINISH:

No casings or screens

AQUIFERS:

Unknown

WATER LEVEL:

10 feet

PUMPING EQUIPMENT: Type Centrifugal Universal H.P. .75
Capacity 25 G.P.M.

WELL TESTS:

Drawdown 20 ft. after hours Pumping 1200 G.P.M.

Drawdown ft. after hours G.P.M.

USE OF WATER Irrigation Temp. °F., 19

SOURCE OF INFORMATION GR-2853

DRILLER or DIGGER Unknown

ADDITIONAL DATA:

Log Water Level Measurements Chemical Analysis Aquifer Test

REMARKS: