

STATE ENGINEER
Salem, Oregon

7482 Well Record
MARION

STATE WELL NO. 7/2W-20E
COUNTY Marion
APPLICATION NO. GR-3048

OWNER: Albert Joseph Patz


MAILING ADDRESS: 4795 Swegle Road

LOCATION OF WELL: Owner's No. #2

CITY AND STATE: Salem, Oregon

SW 1/4 NW 1/4 Sec. 20 T. 7 N. S., R. 2 W., W.M.

Bearing and distance from section or subdivision corner 31.5 chs. S. & 4.4 chs. E.

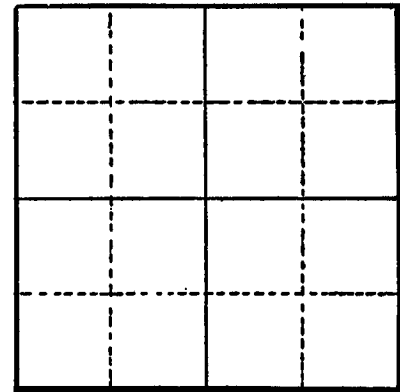

Altitude at well

Section

TYPE OF WELL: Driven Date Constructed 1946

Depth drilled 43 Depth cased 43

CASING RECORD:

1.5-inch

FINISH:

No casings or screens

AQUIFERS:

Unknown

WATER LEVEL:

10 feet

PUMPING EQUIPMENT: Type Berkeley centrifugal H.P. 0.50

Capacity 20 G.P.M.

WELL TESTS:

Drawdown 20 ft. after hours Pumping 1200 G.P.M.

Drawdown ft. after hours G.P.M.

USE OF WATER Irrigation Temp. °F., 19

SOURCE OF INFORMATION GR-2854

DRILLER or DIGGER Unknown

ADDITIONAL DATA:

Log Water Level Measurements Chemical Analysis Aquifer Test

REMARKS: