

STATE ENGINEER
Salem, Oregon

7577
MAR. MAR. 21

Well Record


STATE WELL NO. 7/2W-21B
COUNTY Marion
APPLICATION NO. GR-2049

OWNER: A. R. Siegmund
MAILING ADDRESS: 165 S. Lancaster

LOCATION OF WELL: Owner's No. _____
CITY AND STATE: Salem, Oregon

NW 1/4 NE 1/4 Sec. 21 T. 7 N. S. R. 2 W., W.M.

Bearing and distance from section or subdivision
corner 1683' W. & 264' S.

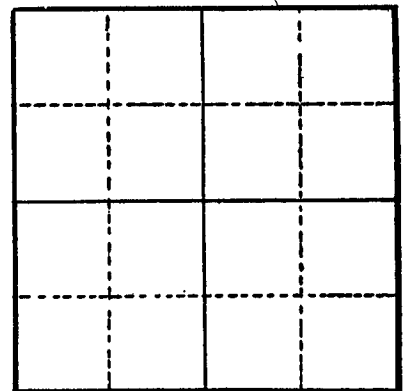

Section

Altitude at well

TYPE OF WELL: Drilled Date Constructed 1944

Depth drilled 90 ft. Depth cased 90 ft.

CASING RECORD:
8-inch

FINISH:

AQUIFERS:
Soil and Gravel

WATER LEVEL:
18 feet

PUMPING EQUIPMENT: Type Turbine Fairbanks Morse H.P. 5.0
Capacity 60 G.P.M.

WELL TESTS:
Drawdown 0 ft. after hours Pumping 60 G.P.M.
Drawdown ft. after hours G.P.M.

USE OF WATER Irrigation Temp. °F., 19

SOURCE OF INFORMATION GR-2855

DRILLER or DIGGER

ADDITIONAL DATA:
Log Water Level Measurements Chemical Analysis Aquifer Test

REMARKS:
Soil 18 72
Cemented gravel 52 20
(some water)
Gravel (water bearing) 20 0