



Oregon Water Resources Department
725 Summer Street NE, Suite A
Salem Oregon 97301
(503) 986-0900
www.wrd.state.or.us

Application for Well ID Number RECEIVED

MAY 04 2011

WATER RESOURCES DEPT.
SALEM, OREGON**FAXED***Do not complete if the well already has a Well I.D. Number.***I. OWNER INFORMATION**

Current Owner Name (please print): Roy & Katherine Stubbs sr.
Mailing Address: 6505 Fruitland Rd NE
City: Salem State: OR Zip: 97317
Mailing Address (to send Well I.D.): Same
City: _____ State: _____ Zip: _____

P.O. Box 174 South Beach OR 97366

II. WELL INFORMATION (Do not complete this section if the well report is attached.)

Township: _____ (North/South) Range: _____ (East/West) Section: _____
Tax Lot: _____ County: _____ 1/4 _____ 1/4
Street Address of Well: _____ City: _____
Owner at time the well was constructed, (if known): L & R Nursery
If the property had a different street address in the past: _____

III. GENERAL WELL INFORMATION (Do not complete this section if the well report is attached)

Use of Well (domestic, irrigation, commercial, industrial, monitoring): Ag
Date Well Constructed: 1980 Total Well Depth: _____ Casing Diameter: 10"
Other Information: _____

SUBMITTED BY (please print): Roy F Stubbs sr
PHONE: 503 559 2078 FAX: 503 663 9220

Send application to Oregon Water Resources Department; 725 Summer St NE, Suite A; Salem, Oregon 97301-1266; fax (503) 986-0902. Applications are processed and Well I.D. Numbers are mailed every Wednesday.

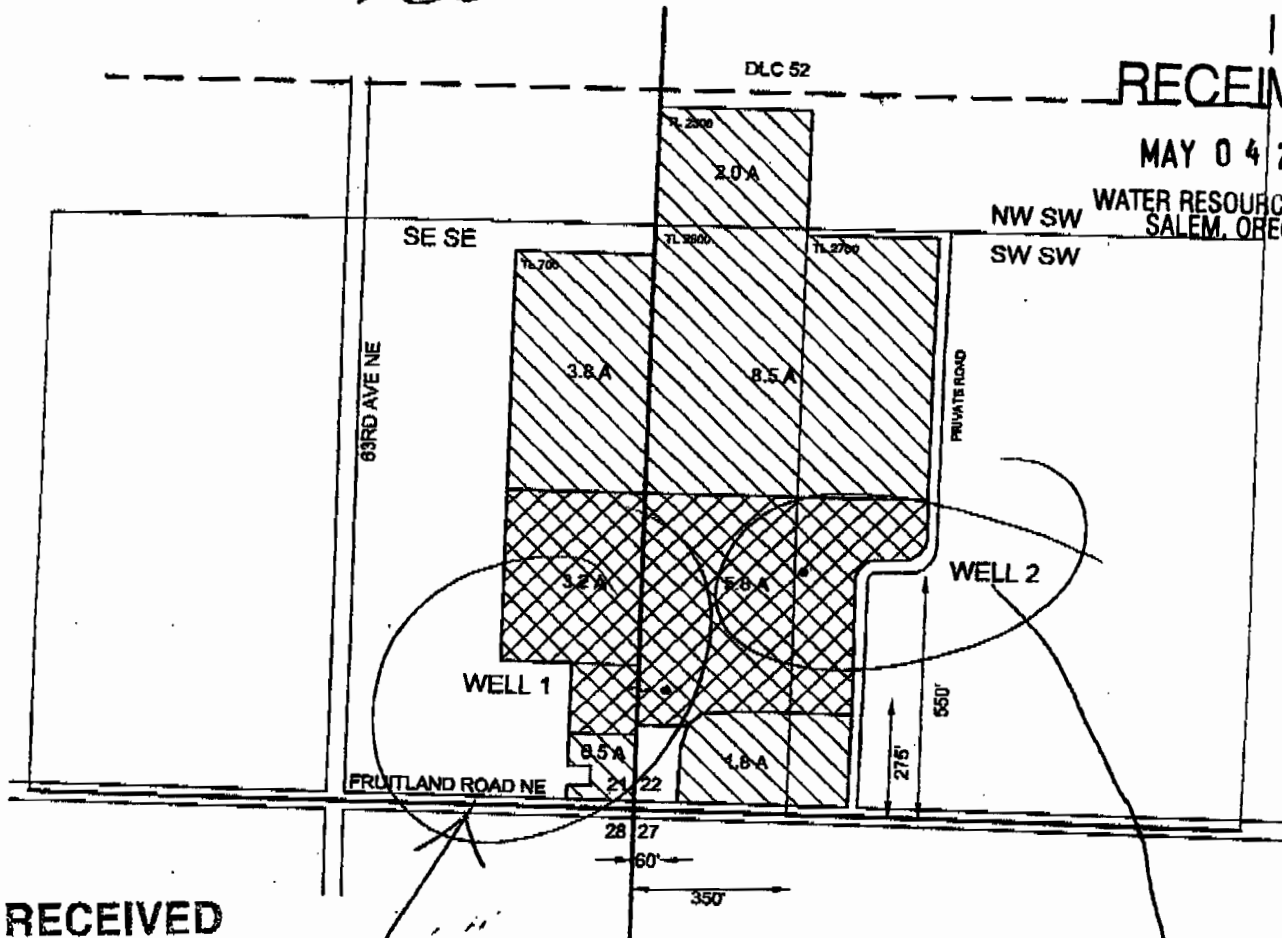
MARI 7601

L-106595

For Official Use Only by the Oregon Water Resources Department.		
Received Date:	Well Log Number:	Well Identification #:
_____	_____	_____

T7S, R2W, Sections 21 & 22, WM
Marion County**FAXED**App #
G 17320**RECEIVED**

MAY 04 2011

WATER RESOURCES DEPT.
SALEM, OREGON**RECEIVED**

MAR 11 2010

WATER RESOURCES DEPT.
SALEM, OREGON

Sipple worked on well no. 2 and repair then installed a tag on that well.

March 10, 2010

THIS MAP IS NOT INTENDED TO
PROVIDE LEGAL DIMENSIONS OR
LOCATIONS OF PROPERTY
OWNERSHIP LINES.

*Well no. 1 has no tag
at this time. Required
to install tag as per
final order*

EXPLANATION:- Proposed Irrigation
(15.6 Acres)- Proposed Nursery (Agriculture) Use
(Greenhouses - 9.0 Acres)**SKOOKUM**

WATER ASSOCIATES INC
P.O. Box 80174
Portland, OR 97280
(503) 319-8926



Scale: 1 inch = 400 feet

**Application Map
for Katherine and
Roy Stubbs Sr.**