

STATE ENGINEER
Salem, Oregon

Well Record

STATE WELL NO. 4/1W-26E(1)
COUNTY Marion
APPLICATION NO. GR-785


M 171 772

OWNER: Lester Will MAILING ADDRESS: Route 1, Box 38

LOCATION OF WELL: Owner's No. #1 CITY AND STATE: Hubbard, Oregon

SW 1/4 NW 1/4 Sec. 26 T. 4 S., R. 1 W., W.M.

Bearing and distance from section or subdivision corner 2250' S. & 200' E. from NW cor. Sec. 26

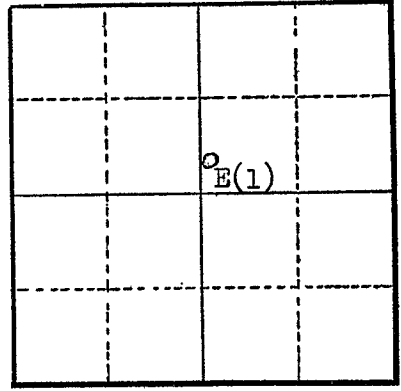

Section 26

Altitude at well 178'

TYPE OF WELL: Drilled Date Constructed Apr. '53

Depth drilled 100' Depth cased 100'

CASING RECORD:

10 inch

FINISH:

AQUIFERS:

WATER LEVEL:

34 feet

PUMPING EQUIPMENT: Type Turbine H.P. 10
Capacity 250 G.P.M.

WELL TESTS:

Drawdown ft. after hours G.P.M.
Drawdown ft. after hours G.P.M.

USE OF WATER Irrigation 32 acres Temp. °F., 19.....

SOURCE OF INFORMATION GR-785

DRILLER or DIGGER J. T. Miller

ADDITIONAL DATA:

Log Water Level Measurements Chemical Analysis Aquifer Test

REMARKS: