

NOTICE TO WATER WELL CONTRACTOR
The original and first copy of this report
are to be filed with the

WATER RESOURCES DEPARTMENT
SALEM, OREGON 97310
within 30 days from the date
of well completion.

MIR. 7. 7 29
RECEIVED
JUN 10 1980

STATE OF OREGON
WATER WELL REPORT
(Please type or print)
(Do not write above this line)

RECEIVED
AUG 25 1980
SALEM, OREGON

2/2w-26ba
G-9042

(1) OWNER:

WATER RESOURCES DEPT

Name Gary Kaufman SALEM, OREGON
Address 635 Justice SE
Salem, OR 97302

(2) TYPE OF WORK (check):

New Well Deepening Reconditioning Abandon

If abandonment, describe material and procedure in Item 12.

(3) TYPE OF WELL:

(4) PROPOSED USE (check):

Rotary Driven Domestic Industrial Municipal
Cable Jetted Irrigation Test Well Other
 Bored

(5) CASING INSTALLED:

Threaded Welded

10" Diam. from +1 ft. to 71 ft. Gage .250
" Diam. from ft. to ft. Gage
" Diam. from ft. to ft. Gage

(6) PERFORATIONS:

Perforated? Yes No.

Type of perforator used

Size of perforations in. by in.
perforations from ft. to ft.
perforations from ft. to ft.
perforations from ft. to ft.

(7) SCREENS:

Well screen installed? Yes No

Manufacturer's Name
Type Model No.
Diam. Slot size Set from ft. to ft.
Diam. Slot size Set from ft. to ft.

(8) WELL TESTS:

Drawdown is amount water level is lowered below static level

Was a pump test made? Yes No If yes, by whom?
gal./min. with ft. drawdown after hrs.
AIR
Baker test 500 gal./min. with 232 ft. drawdown after 8 hrs.
Artesian flow g.p.m.
Temperature of water Depth artesian flow encountered ft.

(9) CONSTRUCTION:

Well seal—Material used Cement
Well sealed from land surface to 71 ft.
Diameter of well bore to bottom of seal 16" to 20' 12"
Diameter of well bore below seal 10 in. 20'-71'
Number of sacks of cement used in well seal 39 sacks
How was cement grout placed? Pressure

Was a drive shoe used? Yes No Plugs Size: location ft.
Did any strata contain unusable water? Yes No
Type of water? depth of strata
Method of sealing strata off
Was well gravel packed? Yes No Size of gravel:
Gravel placed from ft. to ft.

(10) LOCATION OF WELL:

County Marion Driller's well number K 1
N.E 1/4 NW 1/4 Section 26 T. 7S R. 2W W.M.
Bearing and distance from section or subdivision corner

(11) WATER LEVEL: Completed well.

Depth at which water was first found 123 ft.
Static level 68 ft. below land surface. Date 5/23/80
Artesian pressure lbs. per square inch. Date

(12) WELL LOG:

Diameter of well below casing 10" to 30" 8" to 408

Depth drilled 408 ft. Depth of completed well 408 ft.

Formation: Describe color, texture, grain size and structure of materials; and show thickness and nature of each stratum and aquifer penetrated, with at least one entry for each change of formation. Report each change in position of Static Water Level and indicate principal water-bearing strata.

| MATERIAL | From | To | SWL |
|--------------------------|------|-----|-----|
| Topsoil | 0 | 1 | |
| Clay brown med. | 1 | 15 | |
| Clay grey sticky | 15 | 24 | |
| Clay Brown med. | 24 | 26 | |
| Clay White & grey sticky | 26 | 37 | |
| Cemented Gravel | 37 | 64 | |
| Basalt Hard Grey | 64 | 87 | |
| Sandstone Green Hard | 87 | 95 | |
| Claystone Grey Hard | 95 | 101 | |
| Basalt Brn & Crn Wthrd | 101 | 109 | |
| Basalt Brn Wthrd Med. | 109 | 125 | WB |
| Basalt Grey Hard | 125 | 137 | |
| Basalt Grey & Green Hard | 137 | 141 | |
| Basalt Grey Hard | 141 | 158 | |
| Basalt Grey, Brn steaks | 158 | 171 | |
| Basalt Brn, grey porous | 171 | 184 | WB |
| Basalt dk grey med.hrd | 184 | 196 | WB |
| Basalt Grey Hard | 196 | 220 | |
| Basalt dark grey | 220 | 257 | WB |

Work started 5/7 19 80 Completed 5/23 19 80
Date well drilling machine moved off of well 5/23 19 80

Drilling Machine Operator's Certification:

This well was constructed under my direct supervision. Materials used and information reported above are true to my best knowledge and belief.

[Signed] Byron Stadelis Date 5/29, 1980
(Drilling Machine Operator)

Drilling Machine Operator's License No. 1371

Water Well Contractor's Certification:

This well was drilled under my jurisdiction and this report is true to the best of my knowledge and belief.

Name West Coast Drilling Co., Inc.
(Person, firm or corporation) (Type or print)

Address 220 Academy St., Mt. Angel, OR 973

[Signed] Charles E. Stadelis
(Water Well Contractor)

Contractor's License No. 519 Date 5/29, 1980

NOTICE TO WATER WELL CONTRACTOR
The original and first copy of this report
are to be filed with the

WATER RESOURCES DEPARTMENT
SALEM, OREGON 97310
within 30 days from the date
of well completion.

MARI 7729
RECEIVED
JUN 2 1980
WATER WELL REPORT
STATE OF OREGON
Please type or print
(Do not write above this line)
MARI 2667

State Well No. 2skw-26ba
State Permit No. _____

WATER RESOURCES DEPT

(1) OWNER: SALEM, OREGON
Name Gary Kaufman Continued
Address _____

(2) TYPE OF WORK (check):
New Well Deepening Reconditioning Abandon
If abandonment, describe material and procedure in Item 12.

(3) TYPE OF WELL: **(4) PROPOSED USE (check):**
Rotary Driven Domestic Industrial Municipal
Cable Jetted Irrigation Test Well Other
 Bored

(5) CASING INSTALLED: Threaded Welded
_____ " Diam. from _____ ft. to _____ ft. Gage _____
_____ " Diam. from _____ ft. to _____ ft. Gage _____
_____ " Diam. from _____ ft. to _____ ft. Gage _____

(6) PERFORATIONS: Perforated? Yes No.
Type of perforator used _____
Size of perforations _____ in. by _____ in.
_____ perforations from _____ ft. to _____ ft.
_____ perforations from _____ ft. to _____ ft.
_____ perforations from _____ ft. to _____ ft.

(7) SCREENS: Well screen installed? Yes No
Manufacturer's Name _____
Type _____ Model No. _____
Diam. _____ Slot size _____ Set from _____ ft. to _____ ft.
Diam. _____ Slot size _____ Set from _____ ft. to _____ ft.

(8) WELL TESTS: Drawdown is amount water level is lowered below static level
Was a pump test made? Yes No If yes, by whom?
Yield: _____ gal./min. with _____ ft. drawdown after _____ hrs.
" " " " "
" " " " "
Bailer test _____ gal./min. with _____ ft. drawdown after _____ hrs.
Artesian flow _____ g.p.m.
Temperature of water _____ Depth artesian flow encountered _____ ft.

(9) CONSTRUCTION:
Well seal—Material used _____
Well sealed from land surface to _____ ft.
Diameter of well bore to bottom of seal _____ in.
Diameter of well bore below seal _____ in.
Number of sacks of cement used in well seal _____ sacks
How was cement grout placed? _____

Was a drive shoe used? Yes No Plugs _____ Size: location _____ ft.
Did any strata contain unusable water? Yes No
Type of water? _____ depth of strata _____
Method of sealing strata off _____
Was well gravel packed? Yes No Size of gravel: _____
Gravel placed from _____ ft. to _____ ft.

(10) LOCATION OF WELL:
County _____ Driller's well number _____
_____ ¼ _____ ¼ Section T. R. W.M.
Bearing and distance from section or subdivision corner _____

(11) WATER LEVEL: Completed well.
Depth at which water was first found _____ ft.
Static level _____ ft. below land surface. Date _____
Artesian pressure _____ lbs. per square inch. Date _____

(12) WELL LOG: Diameter of well below casing _____
Depth drilled _____ ft. Depth of completed well _____ ft.
Formation: Describe color, texture, grain size and structure of materials; and show thickness and nature of each stratum and aquifer penetrated, with at least one entry for each change of formation. Report each change in position of Static Water Level and indicate principal water-bearing strata.

| MATERIAL | From | To | SWL |
|--------------------------|------|-----|-----|
| Basalt Gry & brn fractur | 257 | 277 | WB |
| Basalt Grey Hard | 277 | 292 | |
| Basalt Dark Green | 292 | 303 | |
| Basalt Grey Porous | 303 | 323 | |
| Basalt Grey Hard | 323 | 341 | |
| Basalt Grey Porous | 341 | 360 | |
| Basalt Black Hard | 360 | 372 | |
| Basalt Black Porous | 372 | 385 | |
| Basalt Black Hard | 385 | 408 | |

RECEIVED
AUG 25 1980
WATER RESOURCES DEPT
SALEM, OREGON

Work started _____ 19 Completed _____ 19
Date well drilling machine moved off of well _____ 19

Drilling Machine Operator's Certification:
This well was constructed under my direct supervision. Materials used and information reported above are true to my best knowledge and belief.
[Signed] _____ Date _____, 19_____
(Drilling Machine Operator)
Drilling Machine Operator's License No. _____

Water Well Contractor's Certification:
This well was drilled under my jurisdiction and this report is true to the best of my knowledge and belief.
Name _____ (Person, firm or corporation) (Type or print)
Address _____
[Signed] _____ (Water Well Contractor)
Contractor's License No. _____ Date _____, 19____

A.M. PETZKA Eng MARI 7729

FROM WATER RESOURCES DEPARTMENT
DAM SAFETY & WELLS DIVISION
555 13th Street N. E.
SALEM, OREGON 97310
PHONE (503) 378-8455

SUBJECT SPECIAL STANDARDS Request.

DATE: 5/12/80

1. IRRIGATION
2. SW of NE Sec 26 T 7S R 2W
3. Gary Kaufman
4. Not Applicable, No house on property
5. gravel Formation overlying the Basalt

Formation, casing driven 7 feet into Rock Formation and will not drive back to allow under Reaming. would like to Perforate Bottom of Casing and pressure grout through perforations as to seal the well
 Well is 10" and annulus is 16" to 20' Below is 12 1/4" same as shoe size

PLEASE REPLY TO → SIGNED

Byron B Stabeli

5/12/80

Special Standards Request approved provided;
 Grout is squeezed from bottom up until it shows at well head & surface pipe pulled.

James E. Jesson Director

by
 A.M. Petzka adm
 Wells & Dam Safety Div.


ww
 OT
 #1358

DATE SIGNED



| | | | |
|--|--|--|---|
| INDUSTRIAL DRILL BITS TAPS & DIES HAND TOOLS POWER TOOLS HOSE/HOSE ENDS ABRASIVES | CHEMICALS LOCTITE PERMATEX LPS WD-40 3M GO-JO | TRUCK PARTS SIGNAL-STAT DIETZ GROTE TRUCK-LITE COLE-HERSEE BERG | BOLTS & NUTS GR. 8 PLATED GR. 6 PLATED GR. 5 PLATED STAINLESS BRASS METRIC |
|--|--|--|---|

S, W, N.E. S 26 R 95 R 2 W GARY KAUFMAN

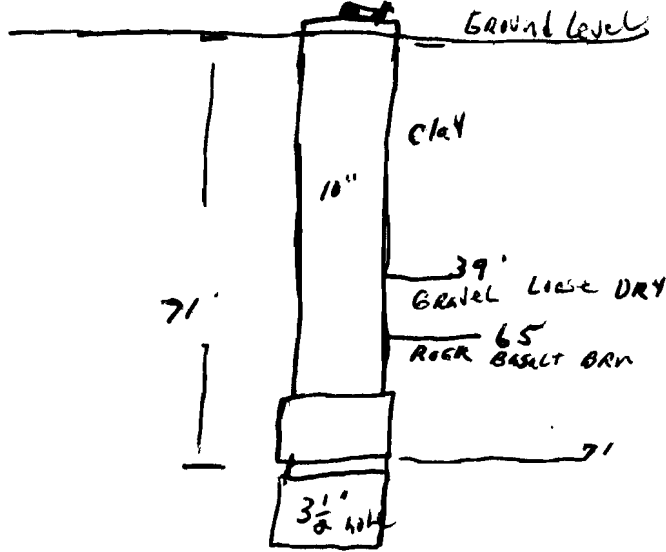

PERF FROM 70' UP TO 65'
PUMP GRUNT UP TO TOP
ON OUTSIDE & 10' UP INSIDE