

STATE ENGINEER
Salem, Oregon

MAR 17 1973

Well Record

STATE WELL NO. 4/1W-26G.1
COUNTY Marion
APPLICATION NO. GR-1614

GR- 1571

OWNER: Ed Budreau


MAILING ADDRESS: Rt. 1

LOCATION OF WELL: Owner's No.

CITY AND STATE: Hubbard, Oregon

SW 1/4 NE 1/4 Sec. 26 T. 4 S, R. 1 W., W.M.

Bearing and distance from section or subdivision
corner 1600' S. & 1900' W. from NE cor. Sec. 26

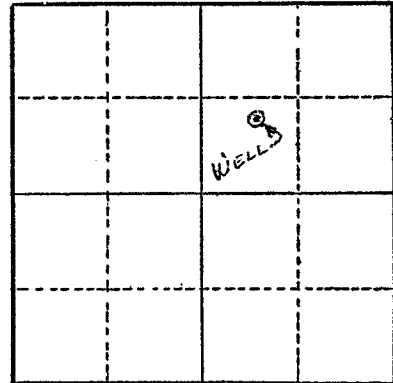

Section 26

Altitude at well

TYPE OF WELL: Drilled Date Constructed 1950

Depth drilled 133' Depth cased 133'

CASING RECORD:

10"

FINISH:

Perforated

AQUIFERS:

Gravel & sand

WATER LEVEL:

?

PUMPING EQUIPMENT: Type Jacuzzi turbine H.P. 30

Capacity 500 G.P.M.

WELL TESTS:

Drawdown 95 ft. after 650 hours G.P.M.

Drawdown ft. after hours G.P.M.

USE OF WATER Irrigation Temp. °F. 19

SOURCE OF INFORMATION GR Record

DRILLER or DIGGER Coleman

ADDITIONAL DATA:

Log N.A. Water Level Measurements Chemical Analysis Aquifer Test

REMARKS:

Irrigation of 48 acres.