

STATE ENGINEER
Salem, Oregon

7746
MARION

Well Record

STATE WELL NO. 7/2W-26M
COUNTY Marion
APPLICATION NO. GR-3925

OWNER: Clyde M. Johnson


MAILING ADDRESS: Route 5, Box 772

LOCATION OF WELL: Owner's No.

CITY AND STATE: Salem, Oregon

NW 1/4 SW 1/4 Sec. 26 T. 7 N. S. R. 2 W., W.M.

Bearing and distance from section or subdivision
corner 2071' S. 0°20' W. and 198' E. from NW Cor.
John L. Eoff DLC

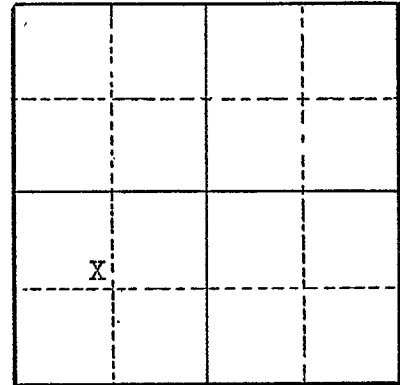

Section 26

Altitude at well

TYPE OF WELL: Drilled Date Constructed Nov., 1948

Depth drilled 71 ft. Depth cased

CASING RECORD:

FINISH:

AQUIFERS:

WATER LEVEL:

PUMPING EQUIPMENT: Type Meyers jet H.P. 1
Capacity 1200 G.P.M.

WELL TESTS:

Drawdown ft. after hours G.P.M.
Drawdown ft. after hours G.P.M.

USE OF WATER Irrigation Temp. °F. 19

SOURCE OF INFORMATION Well Registration Statement Cert. # GR-3561

DRILLER or DIGGER

ADDITIONAL DATA:

Log Water Level Measurements Chemical Analysis Aquifer Test

REMARKS: