

STATE ENGINEER
Salem, Oregon

Well Record

STATE WELL NO. 7/2W - 27P
COUNTY MARION
APPLICATION NO. GR-2042

778//
MARI.....

OWNER: Elmer E. Bolz


MAILING ADDRESS: R. R. 5 Box 755

LOCATION OF WELL: Owner's No. #1

CITY AND STATE: Salem, Oregon

SE 1/4 SW 1/4 Sec. 27 T. 7 N. S., R. 2 E. W., W.M.

Bearing and distance from section or subdivision corner 1700' E. and 400' N.

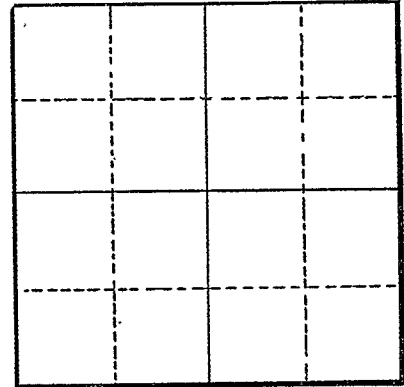

Section

Altitude at well

TYPE OF WELL: Drilled Date Constructed 1952

Depth drilled 112 Depth cased

CASING RECORD:

8-inch

FINISH:

AQUIFERS:

WATER LEVEL:

20-feet

PUMPING EQUIPMENT: Type Jacuzzi Turbine H.P. 10
Capacity 130 G.P.M.

WELL TESTS:
Drawdown ft. after hours Pumping 130 at 100feet G.P.M.
Drawdown ft. after hours G.P.M.

USE OF WATER Irrigation Temp. °F., 19.....

SOURCE OF INFORMATION GR-1968
DRILLER or DIGGER R. Stadel & Sons, Rt. 3, Box 177-A, Silverton, Oregon

ADDITIONAL DATA:
Log Water Level Measurements Chemical Analysis Aquifer Test

REMARKS: