

STATE ENGINEER
Salem, Oregon

Well Record

STATE WELL NO. 7/2W-28B(1)
COUNTY Marion
APPLICATION NO. GR-11

OWNER: Lawrence A. Ballmer

MAILING ADDRESS: 1170 N. Summer Street

LOCATION OF WELL: Owner's No.

CITY AND STATE: Salem, Oregon

NW $\frac{1}{4}$ NW $\frac{1}{4}$ Sec. 28 T. 7 S., R. 2 W., W.M.

Bearing and distance from section or subdivision

corner 127 feet West and 28 $\frac{1}{2}$ feet South from NE

corner, Lot 21, or South 2°19' East 790.5 feet


and North 88°50' East 448.52 feet from the NW

corner, Section 28.

Altitude at well 200 feet interpolated

TYPE OF WELL: Drilled Date Constructed May 1953

Depth drilled 135.5 feet Depth cased 135.5 feet

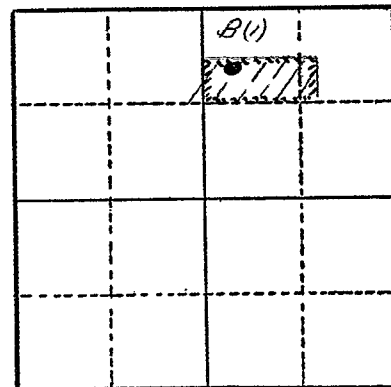

Section 28

CASING RECORD:

8-inch casing set from 0 to 135.5 feet

FINISH:

millor knife perforations, 420 holes from 72 feet to 135 feet

AQUIFERS:

gravels from 80 to 90 feet

WATER LEVEL:

40 feet below land surface May 16, 1953

PUMPING EQUIPMENT: Type Berkeley Deep Well Turbine @50#psi H.P. 10
Capacity 150 G.P.M.

WELL TESTS:

Drawdown 88 ft. after 150 hours G.P.M.

Drawdown ft. after hours G.P.M.

USE OF WATER Irrig. & Dom. 18.5 Temp. °F. 19

SOURCE OF INFORMATION GR-10

DRILLER or DIGGER

ADDITIONAL DATA:

Log Water Level Measurements Chemical Analysis Aquifer Test

REMARKS:

[illegible]