

STATE ENGINEER
Salem, Oregon

7962
MARI.....

Well Record


STATE WELL NO. 7
COUNTY MAH
APPLICATION NO.

OWNER: J. M. Sleighter
MAILING ADDRESS: 5410 Auburn Road

LOCATION OF WELL: Owner's No. _____
CITY AND STATE: Salem, Oregon

SW 1/4 NE 1/4 Sec. 29 T. 7 N. S. R. 2 W., W.M.

Bearing and distance from section or subdivision corner 3200' N. and 2200' W.

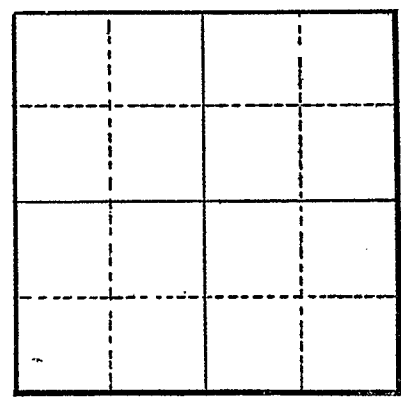

Section

Altitude at well

TYPE OF WELL: Drilled Date Constructed 1949

Depth drilled 60 Depth cased 60'

CASING RECORD:

8-inch

FINISH:

Perforated last ten feet from 50' to 60'

AQUIFERS:

Clay, gravel and sand

WATER LEVEL:

8-feet

PUMPING EQUIPMENT: Type Upright electric H.P. 3
Capacity 90 G.P.M.

WELL TESTS:

Drawdown 20 ft. after _____ hours Pumping 80 G.P.M.
Drawdown _____ ft. after _____ hours _____ G.P.M.

USE OF WATER Irrigation Temp. _____ °F. _____, 19_____

SOURCE OF INFORMATION GR-2345

DRILLER or DIGGER Fred Wymore, Salem Route 2, Oregon

ADDITIONAL DATA:

Log Water Level Measurements _____ Chemical Analysis _____ Aquifer Test _____

REMARKS:

Gumbo clay and humos first 40 feet 40
Clay and gravel 10 Feet 10 50
Mostly gravel and sand 10 60