

STATE ENGINEER
Salem, Oregon

7963
MAR 1948

Well Record


STATE WELL NO. 7/2W-29A
COUNTY MARION
APPLICATION NO. GR-3366

OWNER: Eric R. Nelte
MAILING ADDRESS: 5690 Center Street

LOCATION OF WELL: Owner's No.
CITY AND STATE: Salem, Oregon

NE 1/4 NE 1/4 Sec. 29 T. 7 S., R. 2 W., W.M.

Bearing and distance from section or subdivision corner
1200' S & 450' W from NE cor Sec 29

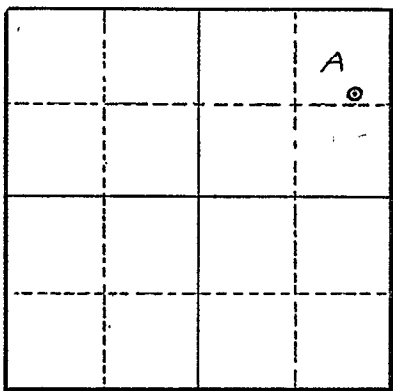

Section 29

Altitude at well

TYPE OF WELL: Drilled Date Constructed 1948

Depth drilled 92' Depth cased top-bottom

CASING RECORD:
6-inch

FINISH:
20 foot 3 x 1/2 inch top to bottom

AQUIFERS:

WATER LEVEL:
27'

PUMPING EQUIPMENT: Type Berkley Turbine H.P. 5
Capacity 100 G.P.M.

WELL TESTS:
Drawdown 45 ft. after hours 120 G.P.M.
Drawdown ft. after hours G.P.M.

USE OF WATER Irrigation Temp. °F., 19

SOURCE OF INFORMATION GR-3973
DRILLER or DIGGER Fred Wymore

ADDITIONAL DATA:
Log NA Water Level Measurements Chemical Analysis Aquifer Test

REMARKS: