

STATE ENGINEER
Salem, Oregon

Well Record

STATE WELL NO. 7/2W-29L
COUNTY Marion
APPLICATION NO. GR-493

OWNER: We, West Foods Inc.

MAILING
ADDRESS:

4949 E. State St.


LOCATION OF WELL: Owner's No. #2

CITY AND
STATE:

Salem, Oregon

NE 1/4 SW 1/4 Sec. 29 T. 7 S, R. 2 W., W.M.

Bearing and distance from section or subdivision
corner 300' E. & 40' N. from SW cor. of NE 1/4 SW 1/4
of Section 29.

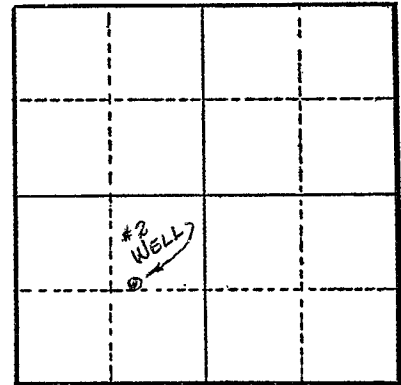

Section 29

Altitude at well 150'

TYPE OF WELL: Drilled Date Constructed 1940

Depth drilled 100' Depth cased 100'

CASING RECORD:

10" from 80 to 100 ft.

FINISH:

AQUIFERS:

WATER LEVEL:

20'

PUMPING EQUIPMENT: Type Turbine H.P. 15
Capacity 300 G.P.M.

WELL TESTS:

Drawdown ft. after hours G.P.M.
Drawdown ft. after hours G.P.M.

USE OF WATER Industrial Temp. °F. 19

SOURCE OF INFORMATION GR Record

DRILLER or DIGGER Wymore

ADDITIONAL DATA:

Log N.A. Water Level Measurements Chemical Analysis Aquifer Test

REMARKS: