

STATE ENGINEER
Salem, Oregon

8019
MAR 21 1941

Well Record

STATE WELL NO. 7/3W-23D
COUNTY Marion
APPLICATION NO. GR-943

OWNER: Curley's Dairy Inc.


MAILING ADDRESS: 1410 Fairgrounds Road

LOCATION OF WELL: Owner's No. # 2

CITY AND STATE: Salem

NW 1/4 NW 1/4 Sec. 23 T. 7 N. S. R. 3 E. W., W.M.

Bearing and distance from section or subdivision corner 550 feet East and 1250 feet South from NW corner, Section 23

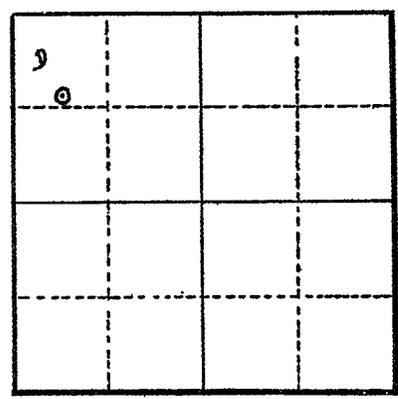

Altitude at well 184 feet

Section 23

TYPE OF WELL: Drilled Date Constructed Sept. 1941

Depth drilled 112 feet Depth cased 112 feet

CASING RECORD:

8-inch steel 0 to 112 feet

FINISH:

30 foot slot perforations 82 to 112 feet

AQUIFERS:

WATER LEVEL:

14 feet

PUMPING EQUIPMENT: Type Fairbanks Morse Jet H.P. 5 Elec. 3 Phase
Capacity 45 G.P.M.

WELL TESTS:

Drawdown ft. after hours G.P.M.
Drawdown ft. after hours G.P.M.

USE OF WATER Industrial * Temp. °F., 19.....

SOURCE OF INFORMATION GR-916

DRILLER or DIGGER Weaver (retired) Brooks, Oregon

ADDITIONAL DATA:

Log Water Level Measurements Chemical Analysis Aquifer Test

REMARKS:

* cooling milk and refrigeration
Topsoil } no strata indicated
Sand and Gravel }
Water at 40 feet cased off