

STATE ENGINEER
Salem, Oregon

MA 21

8018
MARI

Well Record

STATE WELL NO. 7/3W-23D
COUNTY Marion
APPLICATION NO. GR-944

OWNER: Curly's Dairy Inc.


MAILING ADDRESS: 1410 Fairgrounds Road

LOCATION OF WELL: Owner's No. #1

CITY AND STATE: Salem

NW 1/4 NW 1/4 Sec. 23 T. 7 N. S. R. 3 E. W., W.M.

Bearing and distance from section or subdivision corner 650 feet East and 1250 feet South from NW corner, Section 23

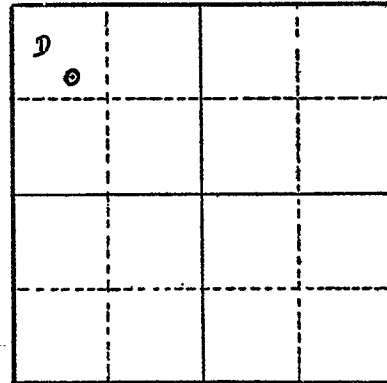

Section 23

Altitude at well 184 feet

TYPE OF WELL: Drilled Date Constructed July 1928

Depth drilled 86 feet Depth cased 86 feet

CASING RECORD:

10" steel casing set from 0 to 86 feet

FINISH:

AQUIFERS:

WATER LEVEL:

14 feet

PUMPING EQUIPMENT: Type Fairbanks Morse Jet H.P. 3 Elec. 3 Phase
Capacity 27 G.P.M.

WELL TESTS:

Drawdown ft. after hours 27 G.P.M.
Drawdown ft. after hours G.P.M.

USE OF WATER Ind. cooling milk Temp. °F. 19

SOURCE OF INFORMATION GR-917

DRILLER or DIGGER Harvey Evans

ADDITIONAL DATA:

Log na Water Level Measurements Chemical Analysis Aquifer Test

REMARKS: