

STATE ENGINEER
Salem, Oregon

MARI 8021
Well Record
GR- 2363


STATE WELL NO. 7/3W-23N
COUNTY Marion
APPLICATION NO. GR-2496

OWNER: Pacific Mutual Life Ins. Co. MAILING ADDRESS: P. O. Box 6050

LOCATION OF WELL: Owner's No. #1 CITY AND STATE: Metropolitan Station Los Angeles 55, California

SW 1/4 SW 1/4 Sec. 23 T. 7 S., R. 3 W., W.M.

Bearing and distance from section or subdivision corner 1200' E. & 360' N. from SW cor. Sec. 23.

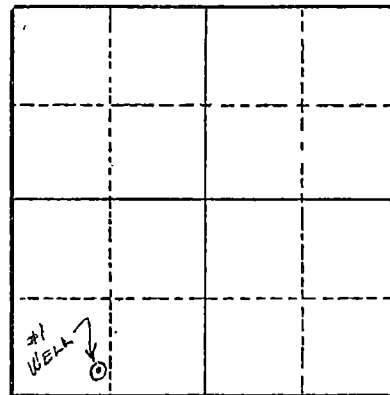

Section 23

Altitude at well 158'

TYPE OF WELL: Drilled Date Constructed 1949

Depth drilled 197' Depth cased 140'

CASING RECORD:

20" O.D.

FINISH:

Perforated from 33 to 38 ft. 72 to 79 1/2 ft. 125 to 129 ft.
55 to 59 1/2 ft. 81 to 85 ft. 131 to 135 ft.
60 1/2 to 64 ft. 113 to 119 1/2 ft.

AQUIFERS:

Sand & gravel

WATER LEVEL:

17'

PUMPING EQUIPMENT: Type Layne & Bowler 8 stage 10" H.P. 50

Capacity 600 G.P.M.

WELL TESTS:	113'			520	
Drawdown	92	ft. after	hours	450	G.P.M.
Drawdown	81	ft. after	hours	400	G.P.M.
	61			300	

USE OF WATER Industrial Temp. °F., 19

SOURCE OF INFORMATION GR Record

DRILLER or DIGGER R. J. Strasser

ADDITIONAL DATA:

Log X Water Level Measurements Chemical Analysis Aquifer Test

REMARKS:

Well located in Sears bldg. in Capitol Shopping Center at Salem.

