

864  
MARION

# Well Record

STATE WELL NO. 4/1W-27K(1)  
COUNTY Marion  
APPLICATION NO. GR33

OWNER: W. T. Lord


MAILING ADDRESS:

LOCATION OF WELL: Owner's No.

CITY AND STATE:

..... 1/4 ..... 1/4 Sec. ..... T. ..... N. ..... E. ....  
..... S., R. ..... W., W.M.

Bearing and distance from section or subdivision corner

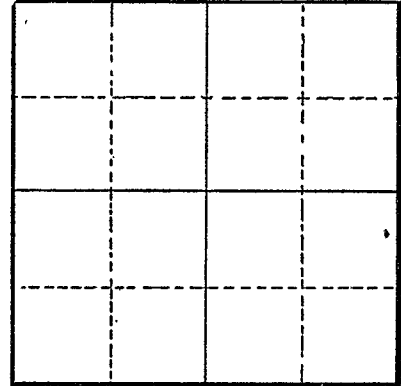

Section

Altitude at well 182

TYPE OF WELL: Drilled Date Constructed 1953

Depth drilled 98 Depth cased 93

### CASING RECORD:

10 inch

### FINISH:

Open bottom, casing unperforated

### AQUIFERS:

Sand from 94 to 98

### WATER LEVEL:

14 feet below land surface on March, 1953

PUMPING EQUIPMENT: Type Turbine

H.P. 10

Capacity 300 G.P.M.

### WELL TESTS:

Drawdown 46 ft. after ..... hours ..... G.P.M.

Drawdown ..... ft. after ..... hours ..... G.P.M.

USE OF WATER Domestic, Irrigation Temp. °F. 19

SOURCE OF INFORMATION USGS

DRILLER or DIGGER

### ADDITIONAL DATA:

Log X Water Level Measurements ..... Chemical Analysis ..... Aquifer Test .....

### REMARKS:

