

STATE ENGINEER
Salem, Oregon

MAR 20 1955

Well Record

STATE WELL NO. 4/1W-27E
COUNTY Marion
APPLICATION NO. GR-3694


OWNER: Guy Wilcox

MAILING ADDRESS: Route 1, Box 19 Pg 1 of 2

LOCATION OF WELL: Owner's No.

CITY AND STATE: Hubbard, Oregon

SE 1/4 SW 1/4 Sec. 27 T. 4 S. R. 1 W., W.M.
Bearing and distance from section or subdivision
corner 630' W. & 530' N. from S1/4 cor. Sec. 27

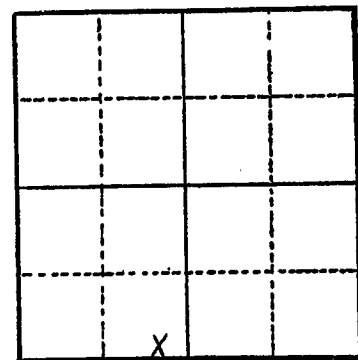

Altitude at well

TYPE OF WELL: Drilled Date Constructed 1948
Depth drilled 120 feet Depth cased 120 feet

Section 27

CASING RECORD:

6 inch steel casing set to 120 feet

FINISH:

perforations from 80 to 120 feet

AQUIFERS:

WATER LEVEL:

20 feet below surface

PUMPING EQUIPMENT: Type Turbine H.P. 3
Capacity 35 G.P.M.

WELL TESTS:
Drawdown little ft. after hours 60 G.P.M.
Drawdown ft. after hours G.P.M.

USE OF WATER Irrigation Temp. °F. 19

SOURCE OF INFORMATION Well Registration Statement

DRILLER or DIGGER

ADDITIONAL DATA:
Log Water Level Measurements Chemical Analysis Aquifer Test

REMARKS:

STATE ENGINEER
Salem, Oregon

805
MAR...5

Well Record

STATE WELL NO. 4/1W-27P(2)
COUNTY Marion
APPLICATION NO.

Pg 2 of 2

OWNER: Guy Wilcox

MAILING ADDRESS:

LOCATION OF WELL: Owner's No.

CITY AND STATE:

..... 1/4 1/4 Sec. T. N. S, R. E. W., W.M.

Bearing and distance from section or subdivision corner

Altitude at well 181

TYPE OF WELL: Drilled. Date Constructed 1948

Depth drilled 120 Depth cased 120

Section

CASING RECORD:

6 inch

FINISH:

Casing perforated 80 to 120

AQUIFERS:

WATER LEVEL:
20 feet

PUMPING EQUIPMENT: Type Turbine H.P. 3
Capacity G.P.M.

WELL TESTS:

Drawdown ft. after hours G.P.M.
Drawdown ft. after hours G.P.M.

USE OF WATER Domestic, Irrigation Temp. °F. 19

SOURCE OF INFORMATION USGS

DRILLER or DIGGER

ADDITIONAL DATA:

Log Water Level Measurements Chemical Analysis Aquifer Test

REMARKS: