

STATE ENGINEER
Salem, Oregon

MARI 8050
Well Record

STATE WELL NO. 7/3W-24G(1)
COUNTY Marion
APPLICATION NO. GR-5

OWNER: Bartel W. Andresen

MAILING

ADDRESS: 445 Candalaria Blvd.

LOCATION OF WELL: Owner's No. _____

CITY AND

STATE: Salem, Oregon

SW $\frac{1}{4}$ NE $\frac{1}{4}$ Sec. 24 T. 7 N. 3 E. 3 W., W.M.

Bearing and distance from section or subdivision

corner 90 feet North and 18 feet West from


corner of Block 1, Roseland Addition, Lot 2,

Block 1

Altitude at well 200 feet interpolated

TYPE OF WELL: Drilled Date Constructed Feb. 1955

Depth drilled 190 feet Depth cased 190 feet

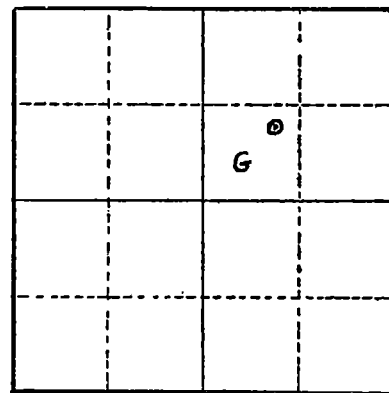

Section 24

CASING RECORD:

8-inch casing set from 0 to 190 feet

FINISH:

$\frac{3}{8}$ " to $\frac{1}{2}$ " perforations from 90 to 173 feet using 10 perf./ft.

AQUIFERS:

gravels from $86\frac{1}{2}$ feet to 190

WATER LEVEL:

44 feet below land surface Feb. 1, 1955

PUMPING EQUIPMENT: Type Fairbanks Morse Turbine H.P. 20
Capacity 250 G.P.M.

WELL TESTS:

Drawdown $3\frac{1}{2}$ ft. after _____ hours 370 G.P.M.

Drawdown 5 ft. after _____ hours 500 G.P.M.

USE OF WATER Municipal Temp. _____ °F. _____, 19_____

SOURCE OF INFORMATION GR-4

DRILLER or DIGGER _____

ADDITIONAL DATA:

Log ☒ Water Level Measurements _____ Chemical Analysis _____ Aquifer Test _____

REMARKS:

8050 MAR 28 1968

State Well No. 7/3W-24(1)
County MARION
Application No. GR-5

[illegible]