

STATE ENGINEER
Salem, Oregon

MARI 8056 MARI

Well Record

STATE WELL NO. 7/3W-24P(1)
COUNTY Marion
APPLICATION NO. GR-678

OWNER: Oregon State Hospital

MAILING ADDRESS:


LOCATION OF WELL: Owner's No. # 2

CITY AND STATE:

Salem, Oregon

SE 1/4 SW 1/4 Sec. 24 T. 7 N. S. R. 3 E. W., W.M.

Bearing and distance from section or subdivision corner 4773 feet South and 3328 feet West of NE corner, Section 24

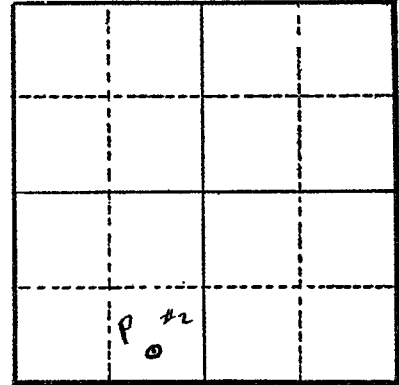

Section 24

Altitude at well 203.42

TYPE OF WELL: Drilled Date Constructed Aug. 10, 1949

Depth drilled 190 Depth cased 190

CASING RECORD:

10-inch

FINISH:

AQUIFERS:

WATER LEVEL:
22 feet

PUMPING EQUIPMENT: Type F. M. Turbine H.P. 20
Capacity 220 G.P.M.

WELL TESTS:
Drawdown 83 ft. after 190 hours G.P.M.
Drawdown 128 ft. after 265 hours G.P.M.

USE OF WATER Irrigation 42.33 Temp. °F. 19
SOURCE OF INFORMATION GR-676

DRILLER or DIGGER
ADDITIONAL DATA:

Log Water Level Measurements Chemical Analysis Aquifer Test

REMARKS: