

STATE ENGINEER
Salem, Oregon

8064
Well Record
MARI


STATE WELL NO. 7/3W-14Q
COUNTY Marion
APPLICATION NO. GR-1856

OWNER: Dairy Cooperative Association MAILING ADDRESS: 1313 S.E. 12th Ave.

LOCATION OF WELL: Owner's No. CITY AND STATE: Portland, Oregon

SW 1/4 SE 1/4 Sec. 14 T. 7 S., R. 3 W., W.M.

Bearing and distance from section or subdivision corner 625' N & 165' E from SW corner Sec. 14

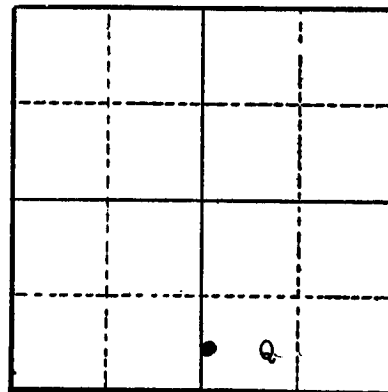

Section 14

Altitude at well

TYPE OF WELL: Drilled Date Constructed 1946

Depth drilled 212' Depth cased

CASING RECORD:

FINISH:

AQUIFERS:

WATER LEVEL:

PUMPING EQUIPMENT: Type Pomona Turbine H.P. 30
Capacity 300 G.P.M.

WELL TESTS:

Drawdown ft. after hours G.P.M.

Drawdown ft. after hours G.P.M.

USE OF WATER Industrial Temp. °F. 19

SOURCE OF INFORMATION GR-3987

DRILLER or DIGGER

ADDITIONAL DATA:

Log NA Water Level Measurements Chemical Analysis Aquifer Test

REMARKS: