

STATE ENGINEER  
Salem, Oregon

8089 Well Record  
M. P. MARI

STATE WELL NO. 7/3W-25G(2)  
COUNTY Marion  
APPLICATION NO. GR-674

OWNER: Oregon State Hospital


MAILING ADDRESS:

LOCATION OF WELL: Owner's No. # 6

CITY AND STATE: Salem, Oregon

SW 1/4 NE 1/4 Sec. 25 T. 7 S., R. 3 W., W.M.

Bearing and distance from section or subdivision corner 1438 feet South and 1838 feet West of NE corner, Section 25.

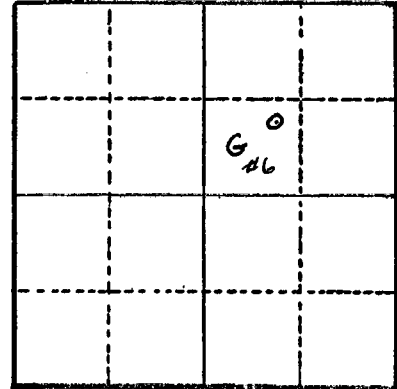

Altitude at well 208.5

Section 25

TYPE OF WELL: Drilled Date Constructed Sept. 24, 1949

Depth drilled 179 Depth cased 179

CASING RECORD:

10-inch casing set from 0 to 153 feet  
8-inch casing set from 152 to 179 feet

FINISH:

AQUIFERS:

WATER LEVEL:

30 feet

PUMPING EQUIPMENT: Type F. M. Turbine H.P. 20  
Capacity 220 G.P.M.

WELL TESTS:

Drawdown 80 ft. after 190 hours G.P.M.  
Drawdown ft. after hours G.P.M.

USE OF WATER Domestic-Irrigation 49 Temp. °F. 19

SOURCE OF INFORMATION GR-672

DRILLER or DIGGER

ADDITIONAL DATA:

Log x Water Level Measurements Chemical Analysis Aquifer Test

REMARKS:

Top soil	0	3	3	Sand & gravel	90	102	12
Clay and silt	3	38	35	Cemented gravel	102	137	35
Clay and gravel	38	45	7	Sand & gravel	137	145	8
Cemented gravel	45	65	20	Cemented gravel	145	171	26
Gravel W/some water	65	72	7	Sand & gravel	171	177	6
Cemented gravel	72	90	18	Gravel W/clay binder	177	179	2